


T.10S. R.40E. W.M.

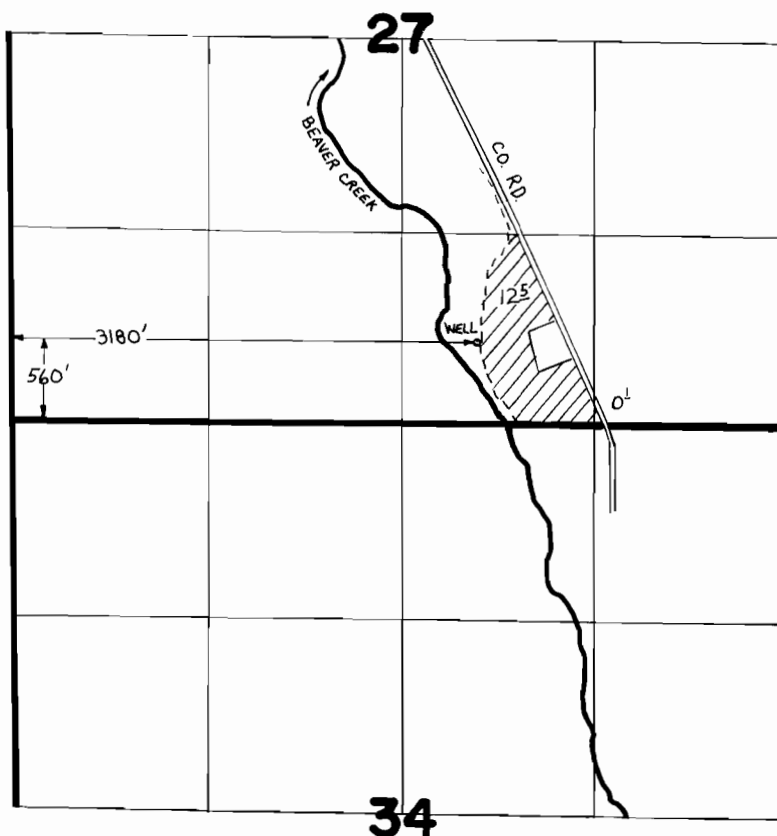

Scale 1" = 1320'



FINAL PROOF SURVEY UNDER

Application No. G.8897... Permit No. G.8305.....
IN NAME OF

MR. & MRS. RODNEY J. MILLER

Surveyed June 3, 1986, by V. Church.....