


T.9S.,R.1W.,W.M.

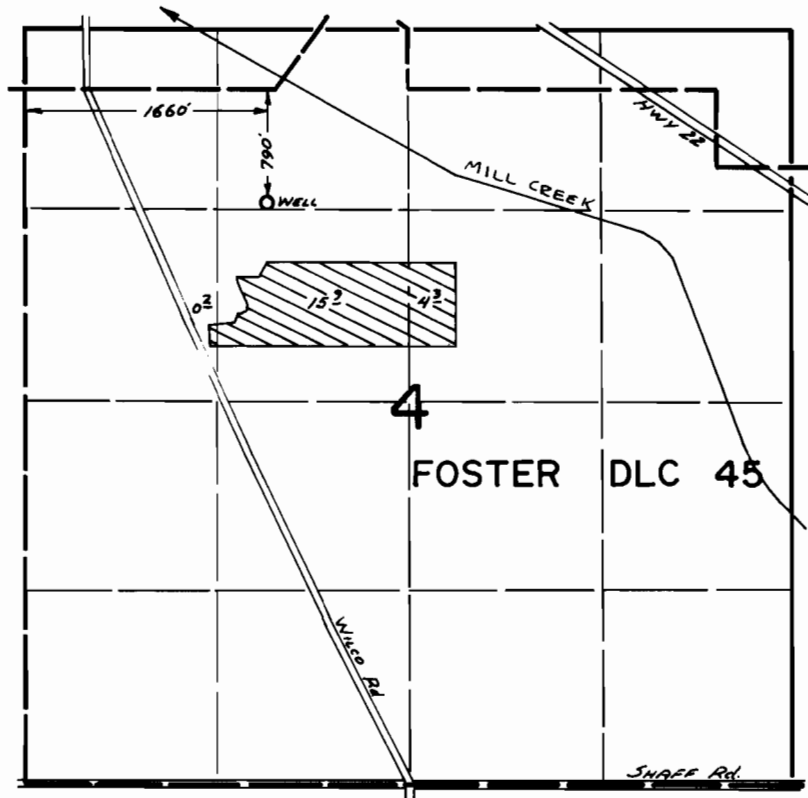

**FINAL PROOF SURVEY**  
UNDER

Application No. G-8963 Permit No. G-8321.....  
IN NAME OF

.....**FRANCIS MACK**.....

Surveyed July 28, 1981, by L. TOLL.....