

Application No. G-8307
Permit No. G 7770


RECEIVED

AUG - 4 1977

WATER RESOURCES DEPT
SALEM, OREGON

T 40 S., R 19 E. W.M.

P: G-8327
58995

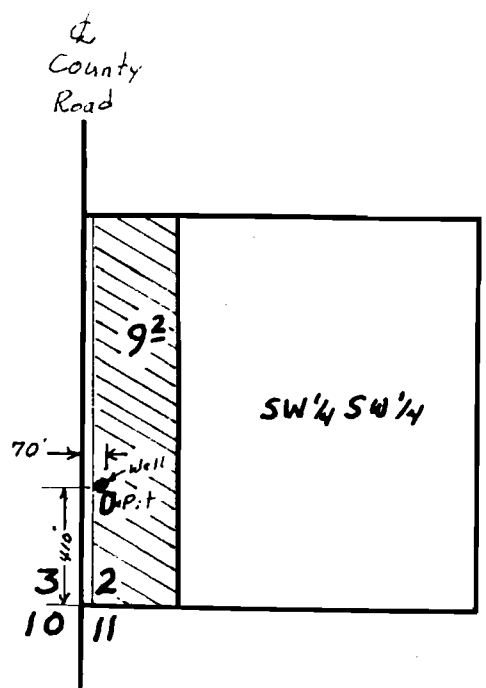

THIS MAP PREPARED BY:
Edward Daggett
FROM INFORMATION FURNISHED BY
THE APPLICANT

Scale 8" = 1 mile ±

Map approved by: Barbara Struck
Applicant