


T.36S., R.1W., W.M.

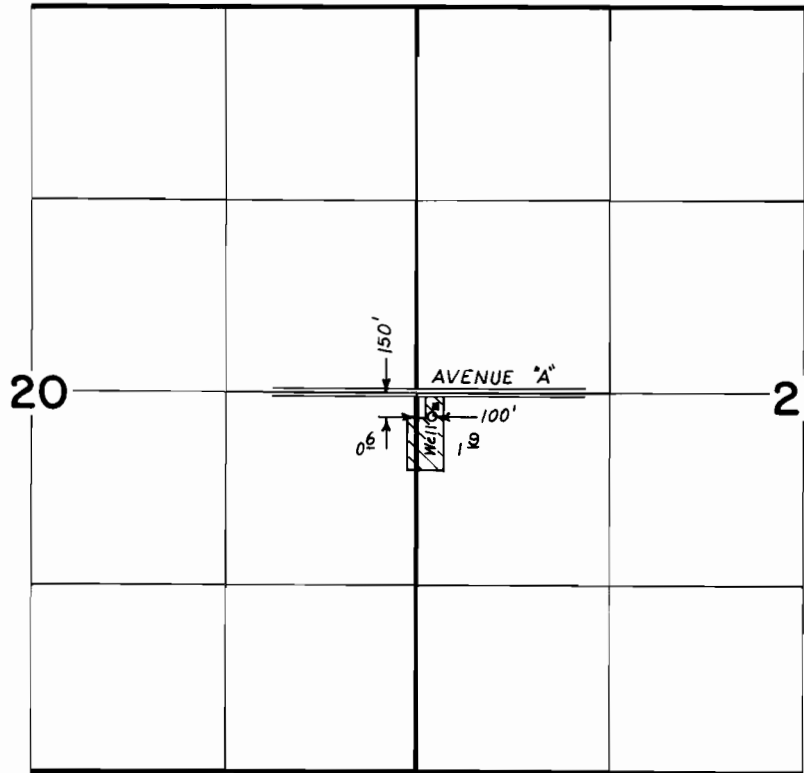

SCALE: 1" = 1320'

**FINAL PROOF SURVEY**  
UNDER

Application No. **G-8957** Permit No. **G-8336**  
IN NAME OF

**HOWARD &/or ANN TODD**

Surveyed **JUNE 14, 1984**, by **TIM W. BURKS**