


T. 4S., R. 1W., W. M.

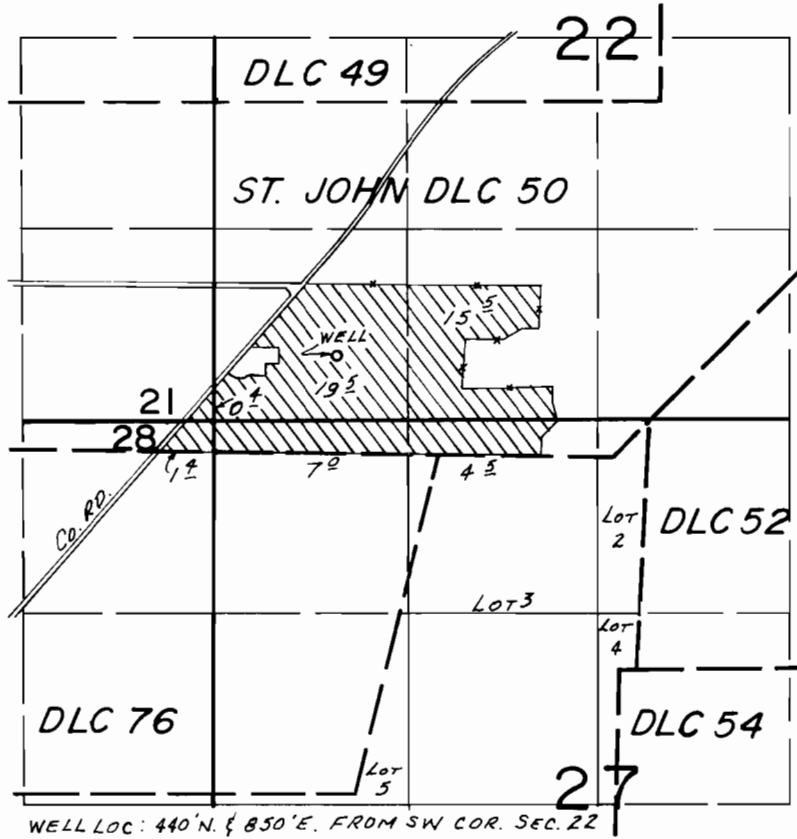

FINAL PROOF SURVEY
UNDER

Application No. G-8954. Permit No. G-8339.....
IN NAME OF

.....PAUL H. DAILY.....

Surveyed OCT. 28. 1983., by L. M. TOLL.....