


T.24S.,R.30E.,W.M.

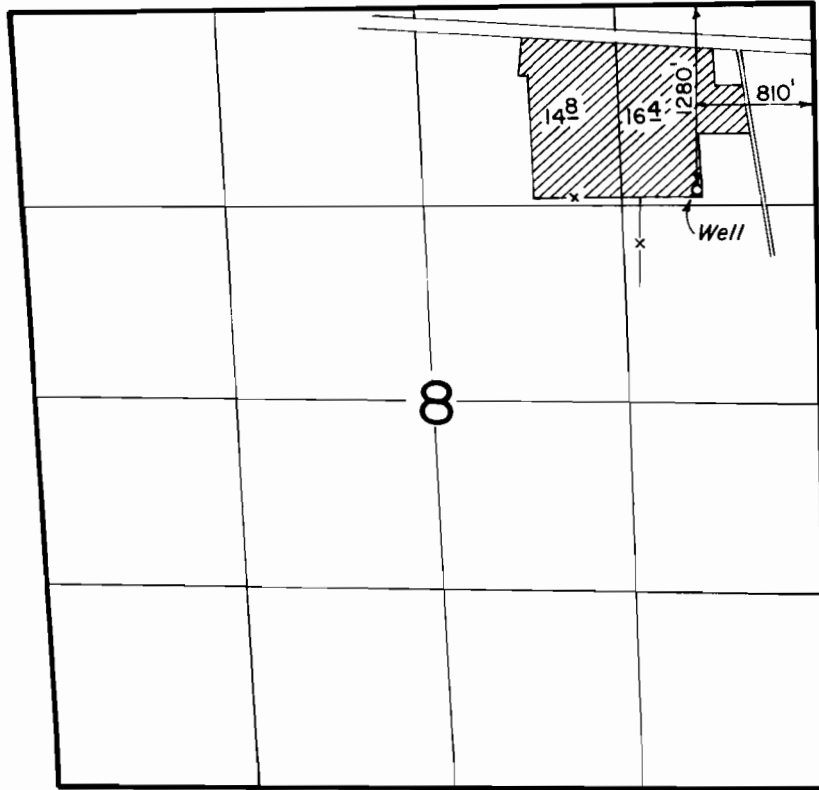

FINAL PROOF SURVEY
UNDER

Application No. G-8997 Permit No. G-8374

IN NAME OF

WILLIAM R. MARTIN

Surveyed JULY 11, 1980, by *dlb*