


T. 5 S., R. 3 W., WM.

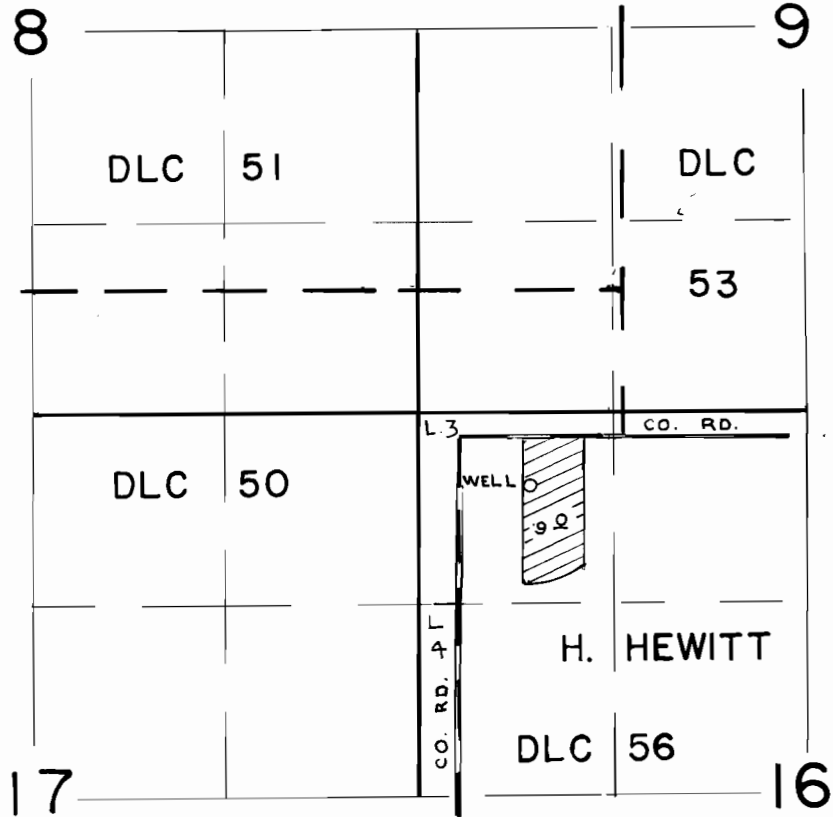

DIV. PT. LOC. 340' S. & 490' E. OF NW. COR. DLC. 56

FINAL PROOF SURVEY
UNDER

Application No. G 8988 Permit No. G 8384
IN NAME OF

JOHN DARREL CLOW

Surveyed APR. 26, 1984, by P. PAGTER