
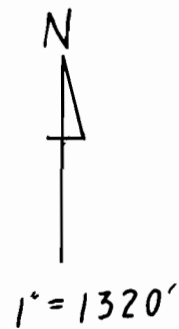


# T.6S R.3W W.M.

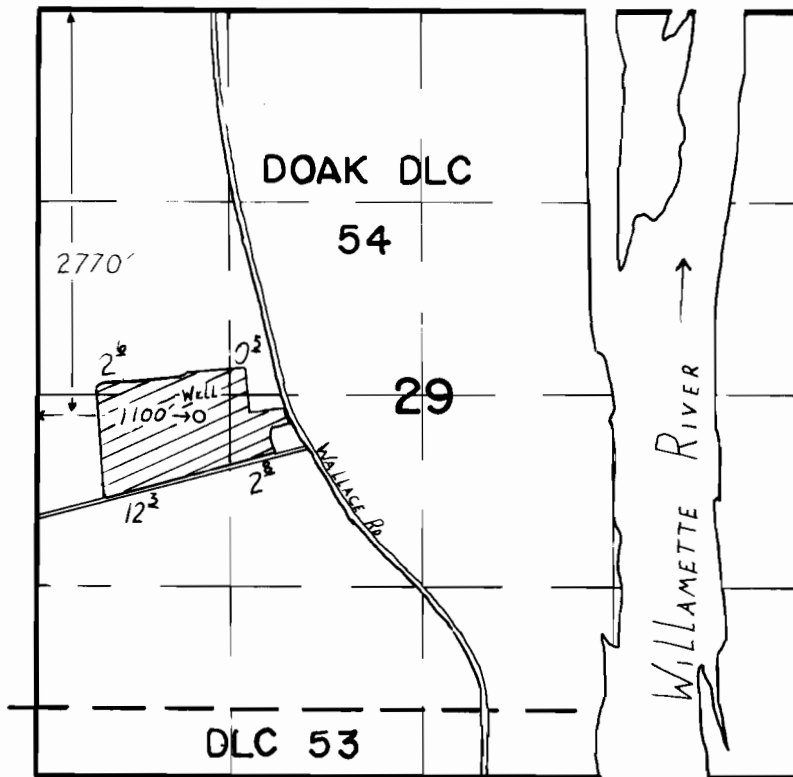

## FINAL PROOF SURVEY UNDER

Application No. G 9048 Permit No. G 8392  
IN NAME OF

ROBERT HINES

Surveyed MAR, 25 1988, by T.M. WARREN