
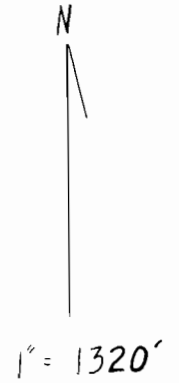


# T.1S R.4E. W.M.

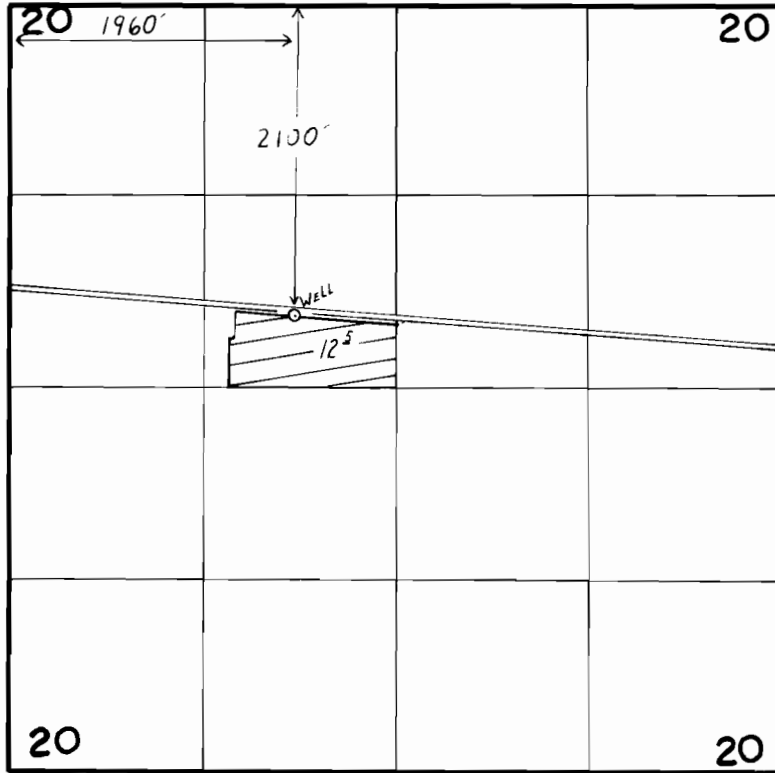

## FINAL PROOF SURVEY UNDER

Application No. G. 9181 Permit No. G. 8497  
IN NAME OF

ROBERT L. DAVIDSON

Surveyed MAY 12 1987, by J. M. WARREN