


T.2S R.3E W.M.

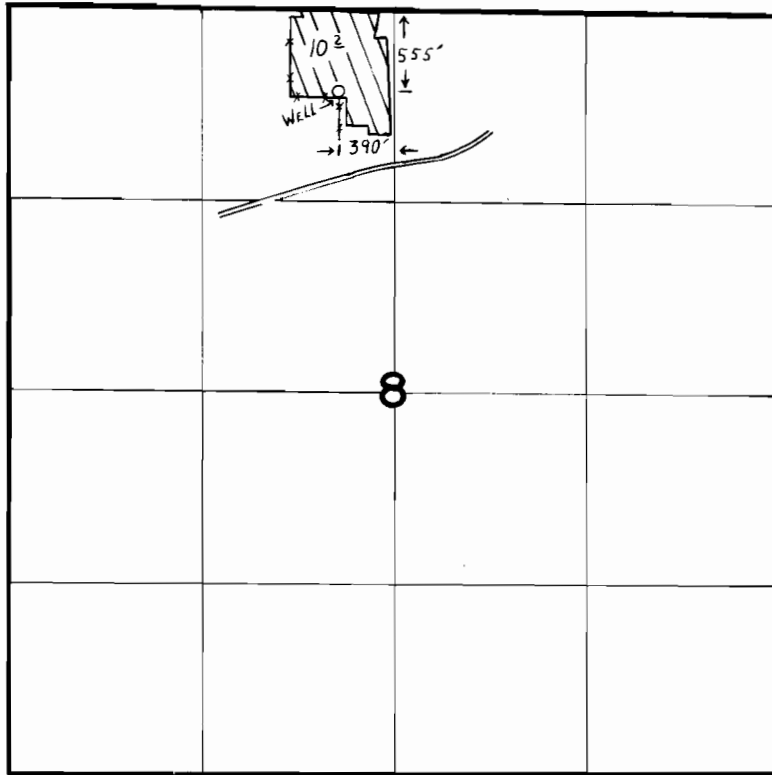

1" = 1320

FINAL PROOF SURVEY UNDER

Application No. *G.9107* Permit No. *G.8518*
IN NAME OF

THE PLANTSMEN NURSERY

Surveyed *JUNE, 5, 1987*, by *T.M. WARREN*