


T.4S R.4E W.M.

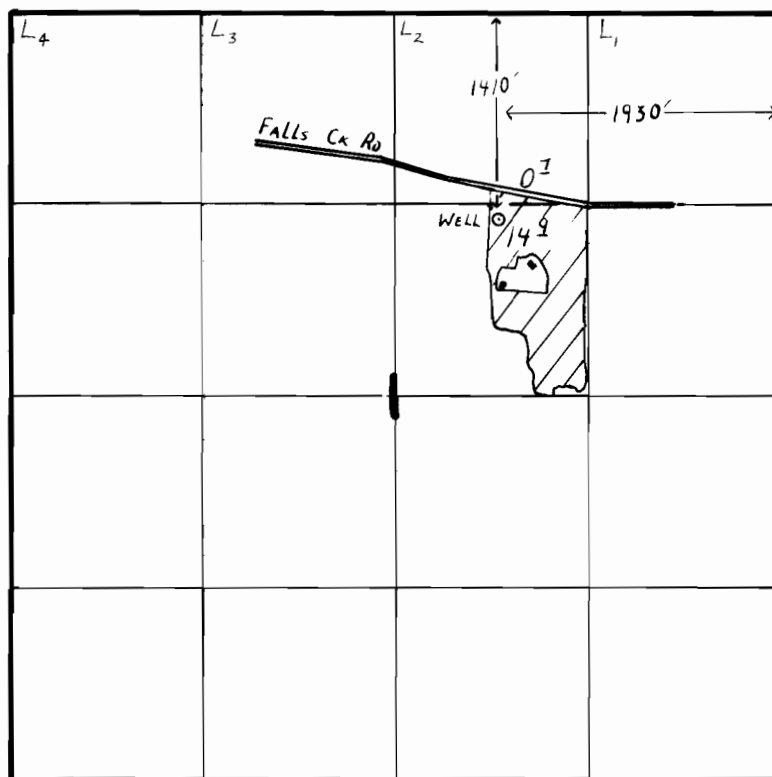

N
1" = 1320'

FINAL PROOF SURVEY
UNDER

Application No. G.9711 Permit No. G.9039
IN NAME OF

HOWARD & EUNICE PEDDERSEN

Surveyed July 13 1987, by T.M. WARREN