


T. 30 S., R. 6 W., W.M. SECTION 9

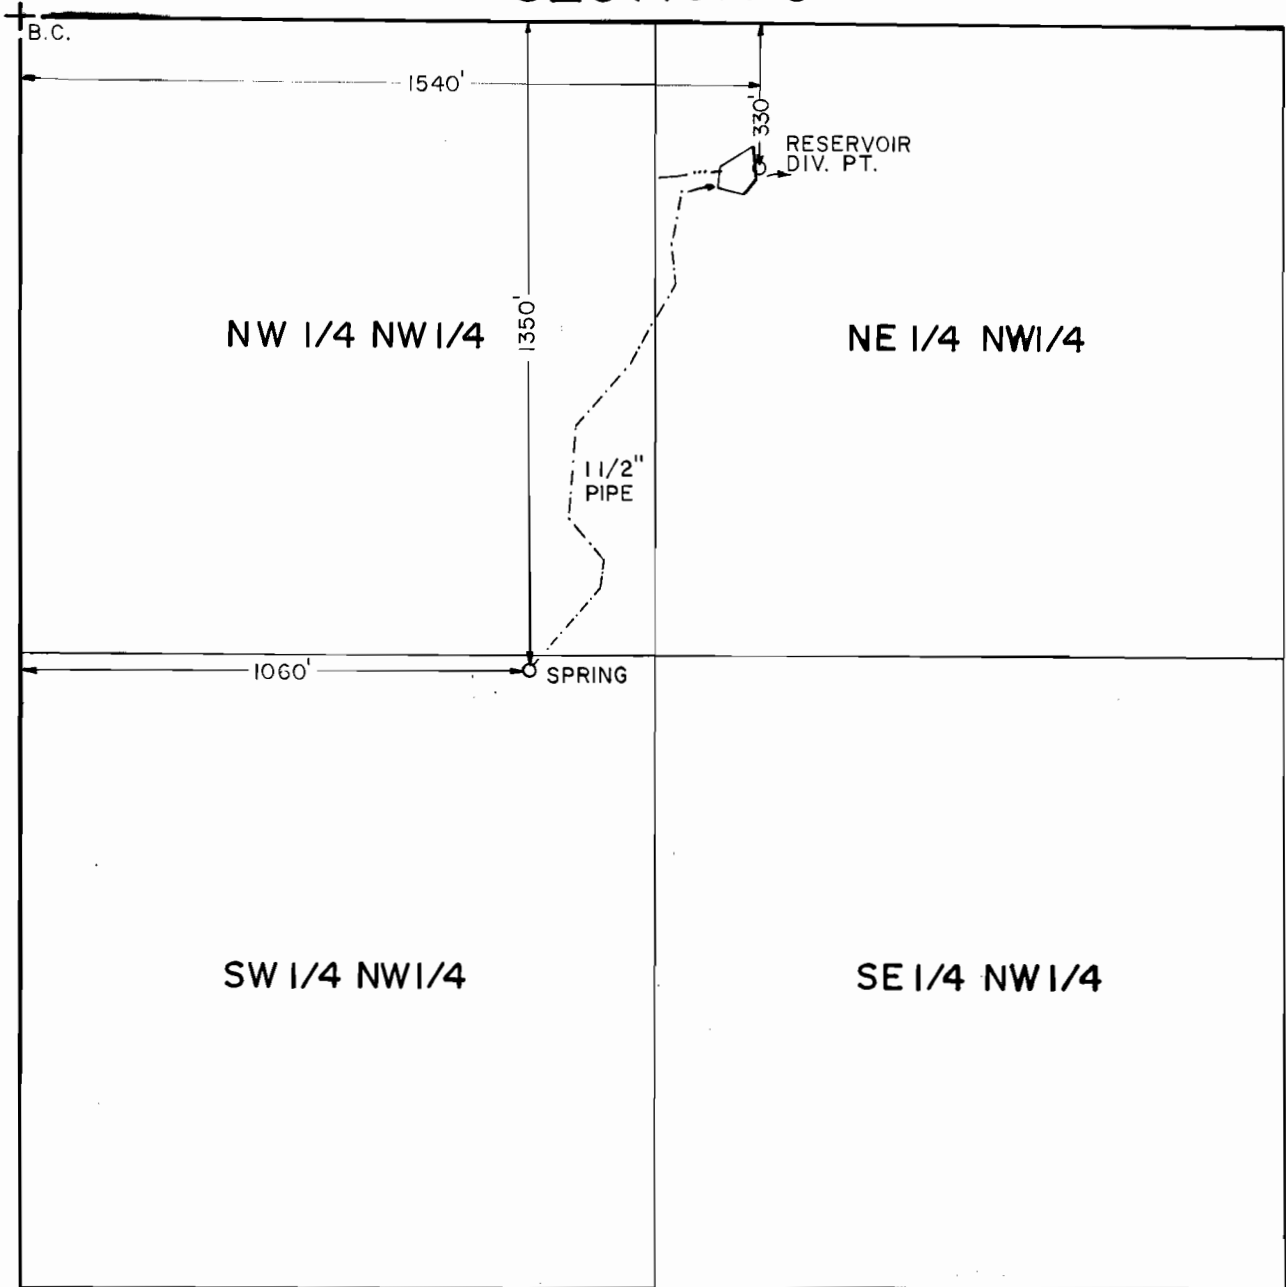

SCALE 1" = 400'

FINAL PROOF SURVEY UNDER

Application No. 55998 R-56010 Permit No. 42386 R-6710

IN NAME OF

BUREAU OF LAND MANAGEMENT

Surveyed JUNE 28 19 84, by L. E. CASHION