
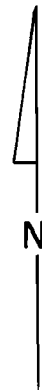


T.2S., R.4W., W.M.

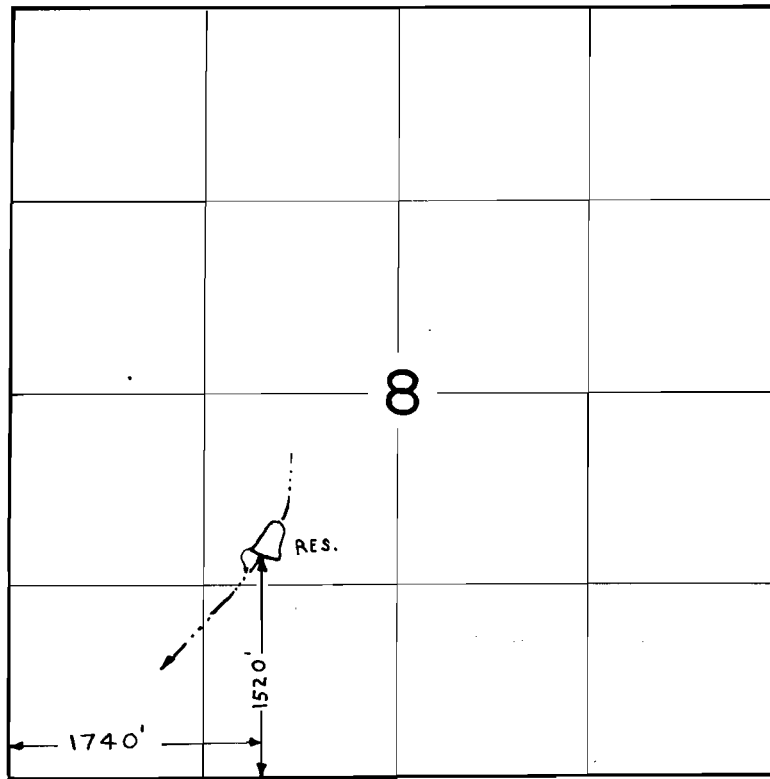

SCALE
1" = 1320'

FINAL PROOF SURVEY
UNDER

Application No. R. 58839. Permit No. R. 7842....
IN NAME OF

AL GRABHORN

Surveyed AUG. 20. 1984, by P. PAGTER