



T.18S., R.4W., W.M.

(SECTION 36)

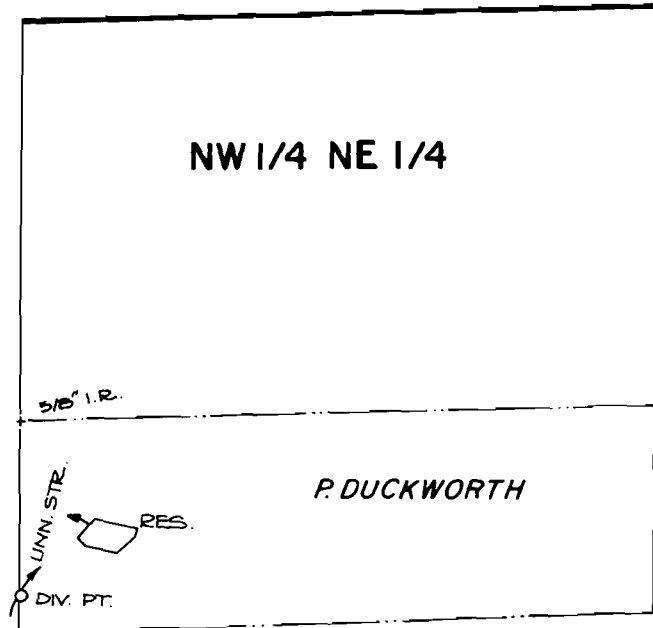

THE DAM IS LOCATED 1050 FT. S. AND 140 FT. E.  
FROM THE N. 1/4 CORNER OF SEC. 36.  
DIV. PT. LOCATED 1200 FT. S FROM THE  
N. 1/4 CORNER OF SEC. 36.

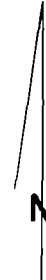

SCALE: 1" = 400'

**FINAL PROOF SURVEY**  
UNDER

Application No. R-58946 Permit No. R-8134.....  
IN NAME OF

.....**PAUL DUCKWORTH**.....

Surveyed AUG. 28., 1984., by P. Patten.....