
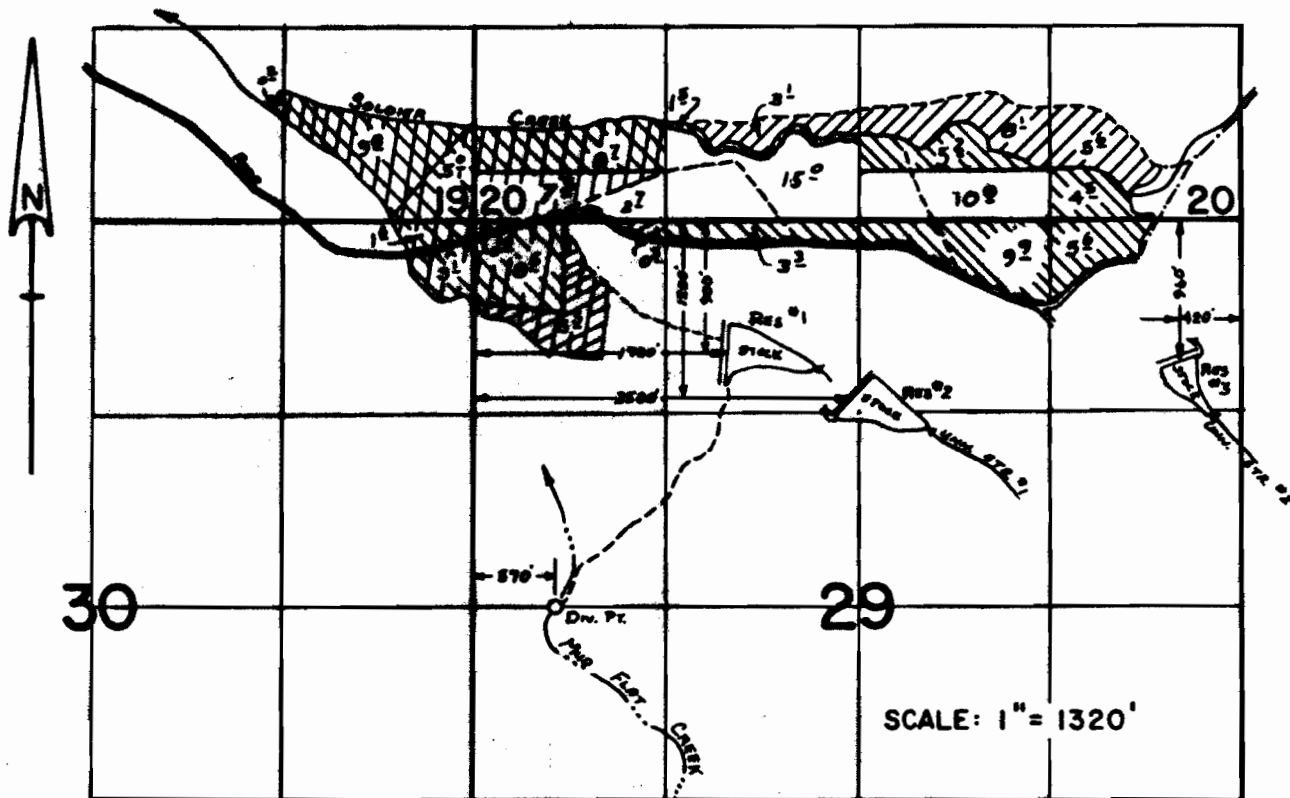


T.32S.,R.45E.,W.M.

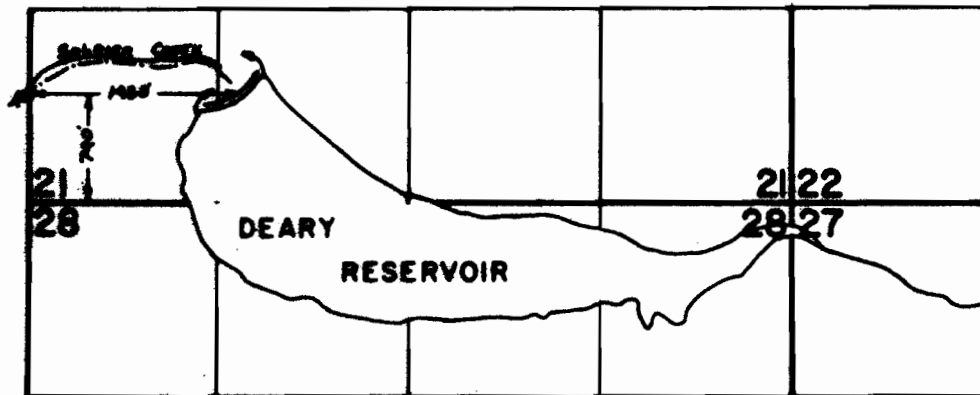

FINAL PROOF SURVEY

UNDER

R-53849
53850
R-58737

R-6467
40580
R-9687

P

S



Application No. 58738 Permit No. 48418

IN NAME OF

RAYMOND E. GLUCH

Surveyed Oct. 15, 1985, by L.M. TOLL