


# T.8S.,R.5W.,W.M.

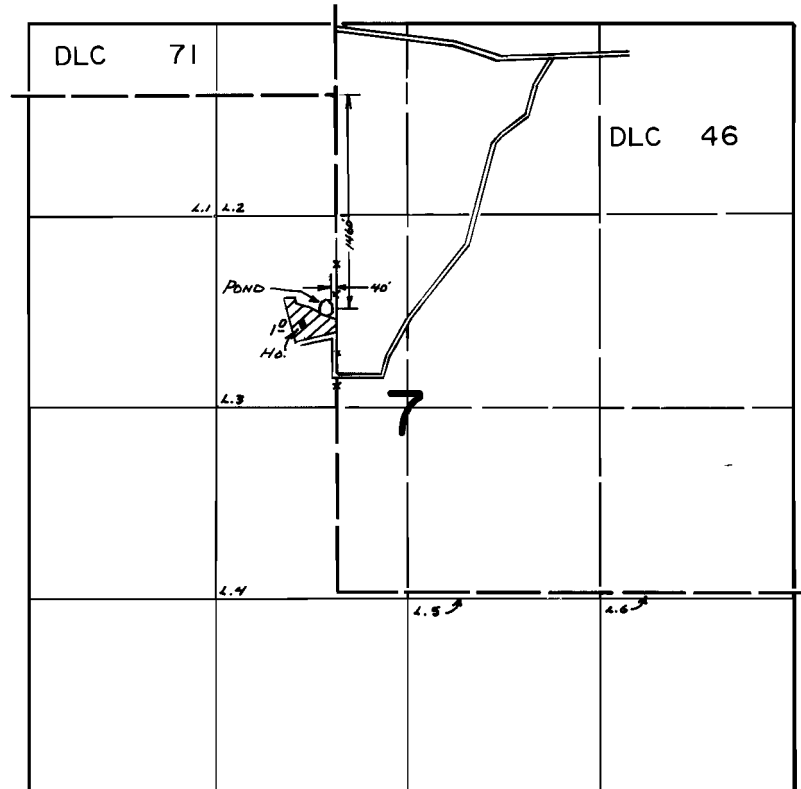

## FINAL PROOF SURVEY

UNDER

R-56892 R-7019  
Application No. ~~56893~~ Permit No. ~~42841~~.....  
IN NAME OF

.....F. M. COWMAN.....

Surveyed Sept. 10. 19.81., by ...L. TOLL.....