T.6S.,R.5W.,W.M.

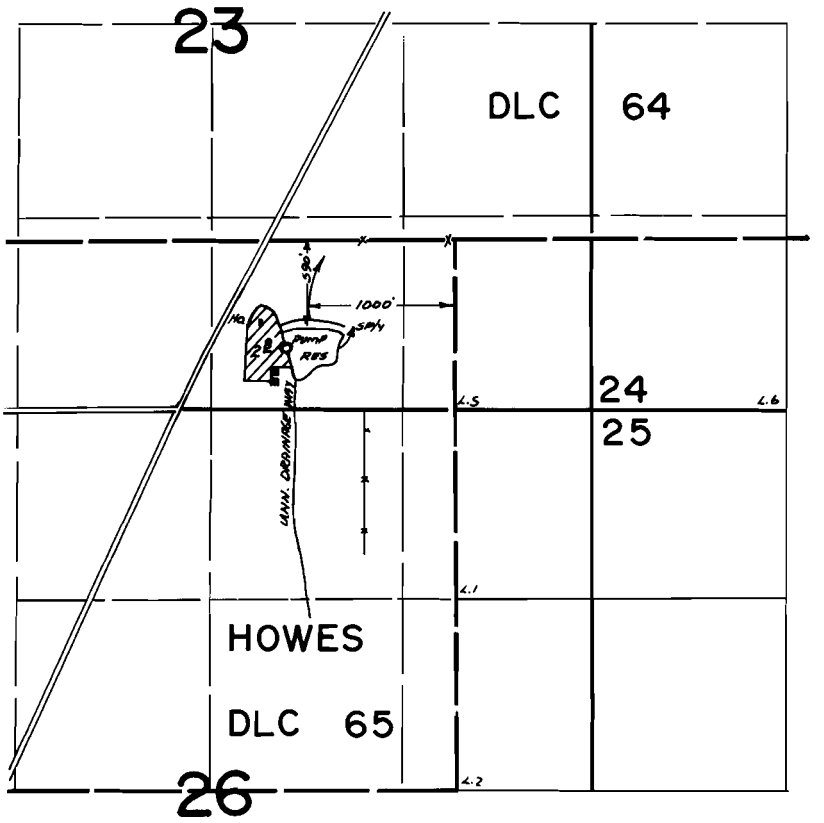

FINAL PROOF SURVEY

UNDER

Application No. R-57079 57080 Permit No. R-7246 43035

IN NAME OF

HAL L. STAPLETON

Surveyed Nov. 10. 19.81., by L. TOLL

DFP-2LL-4
PTS 1975-P