


T.6S.,R.5W.,W.M.

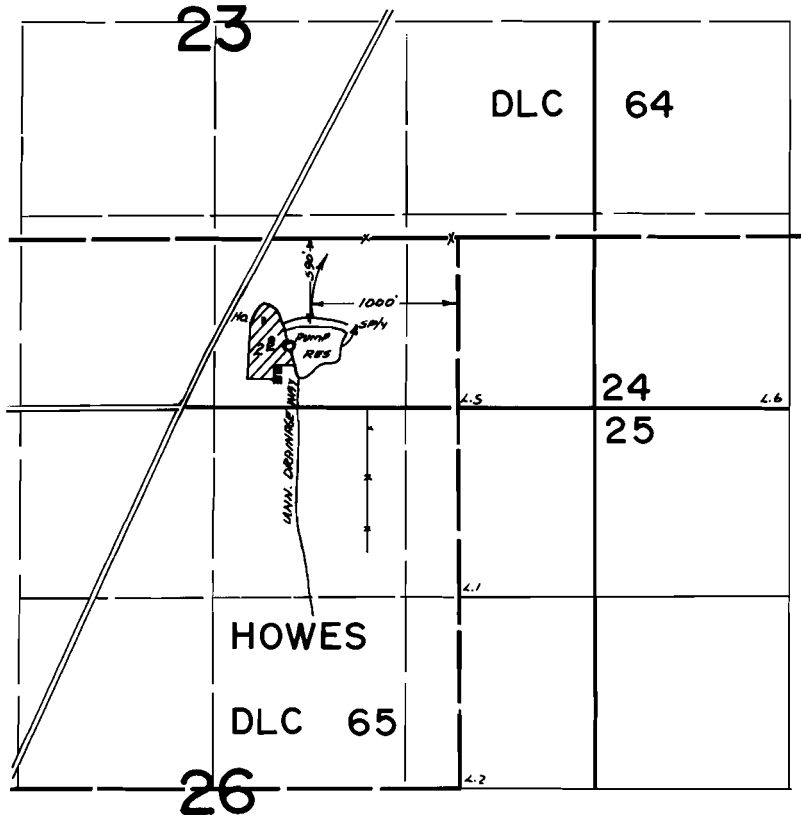

FINAL PROOF SURVEY
UNDER

R-57079 R-7246
Application No. ~~57080~~ Permit No. ~~43035~~.....
IN NAME OF

HAL L. STAPLETON

Surveyed ~~Nov. 10.~~ 19.8.1., by ~~L. TOLL~~.....