


T. 2N., R. 9E., W.M.

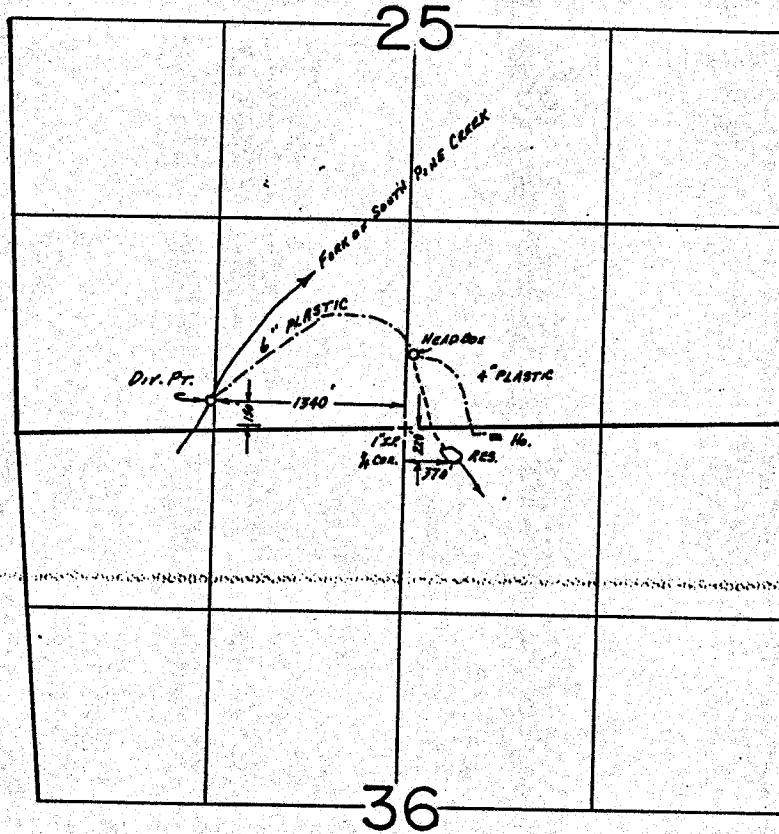

FINAL PROOF SURVEY
UNDER

R-57327 R-7676
Application No. 57328 Permit No. 43316
IN NAME OF

EDWIN J. DENNIS

Surveyed APR. 18, 1980, by R. G. MUCKEN