


T. 40 S., R. 8 W., W.M.

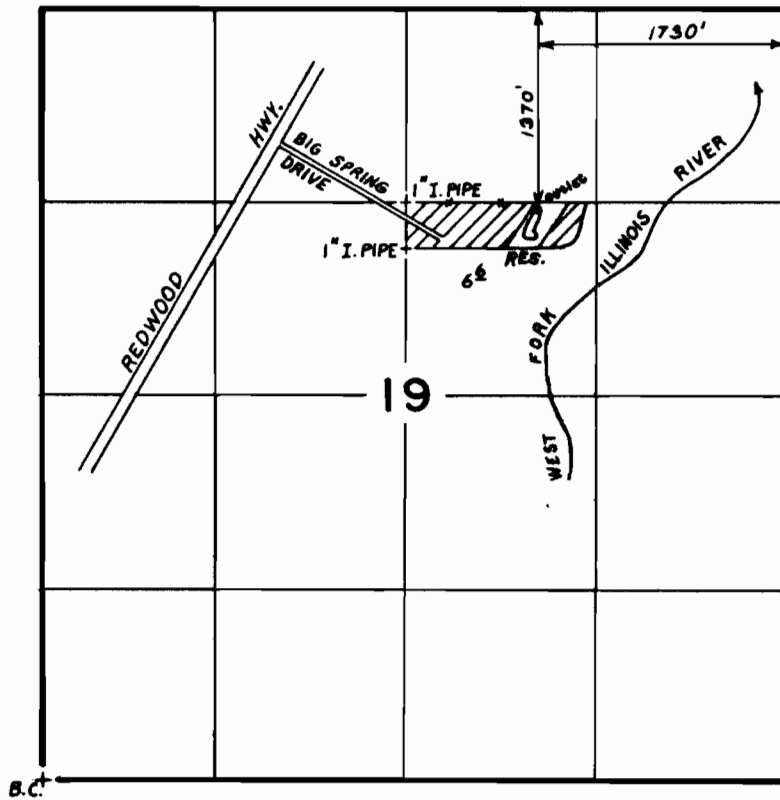

Scale: 4" = 1 MILE

FINAL PROOF SURVEY

UNDER

R-57348

R-7682

Application No. 57349 Permit No. 43340

IN NAME OF

.....CLIFFORD T. GATES.....

Surveyed March 26 1984, by B.S. JAMES.....