


T.7S.,R.5W.,W.M.

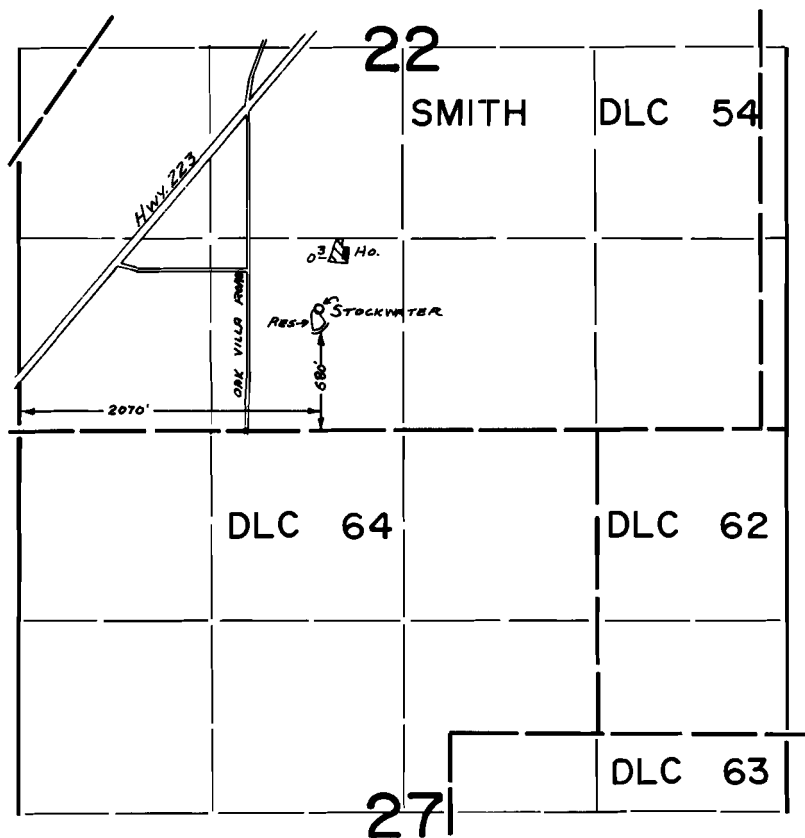

FINAL PROOF SURVEY UNDER

R-57761 R-7768
Application No. 57762. Permit No. 43764.....
IN NAME OF

HENRY R. & AUGUSTA L. KLIEWER

Surveyed Oct. 14, 1981, by L. TOLL.....