


T.5S., R.4 & 5 W., W.M.

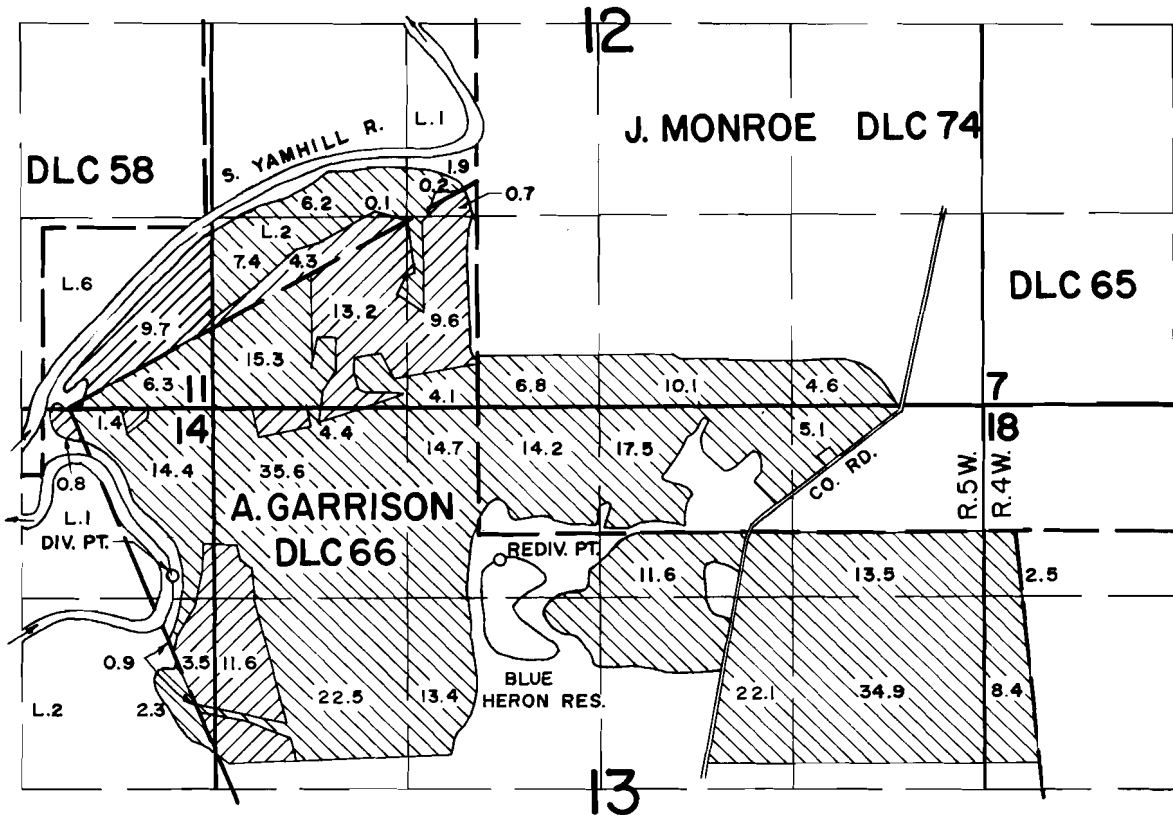

DIV. PT. LOCATION: 250 FT. S. AND 2100 FT. W.; DAM LOCATION: 450 FT. S. AND 20 FT. E.; BOTH FROM THE S.W. CORNER OF MONROE DLC 74.

 PRIMARY

 SUPPLEMENTAL

FINAL PROOF SURVEY

UNDER

N

SCALE: 4" = 1 MILE

R-58263 R-7840
 Application No. 58264 Permit No. 44308
 IN NAME OF

.....PETER.....DINSDALE.....

Surveyed OCT. 4, 1984, by P. Pagter