90684

T. 2 S., R. 4 & 5 W., WM

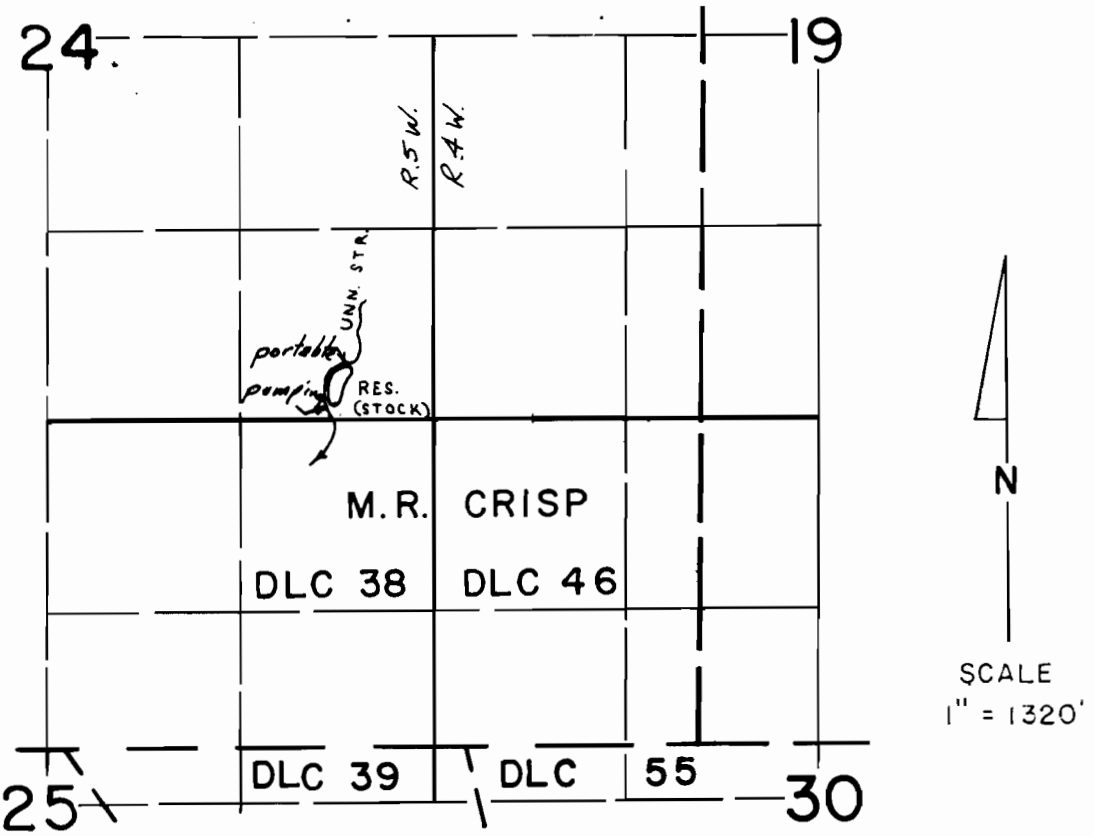

PORTABLE PUMPING BETWEEN: UPSTREAM PT. 390' N. & 610' W. AND DOWNSTREAM PT. 80' N. & 730' W. OF SE COR. SEC 24

FINAL PROOF SURVEY
UNDER

Application No. R 58491 Permit No. R 7841
IN NAME OF

DONALD R. HEIDGERKEN

Surveyed SEP 17 1984, by P. PAGTER

41071 - 178 - 84 R P.G.T.