


T.3S.,R.1E.,W.M.

SECTION 5

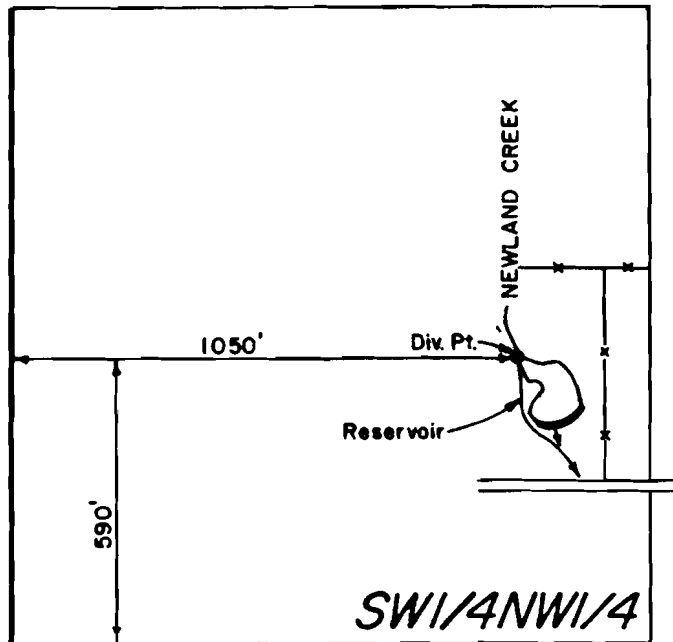

SCALE 1"=400'

FINAL PROOF SURVEY
UNDER

R-60904 R-8218
Application No. 60905 Permit No. 45431
IN NAME OF

Jerry C. & Gayle A. Reeves

Surveyed AUG. 3, 1981, by *[Signature]*