


T.26S., R.3W., W.M.

SEC. 33

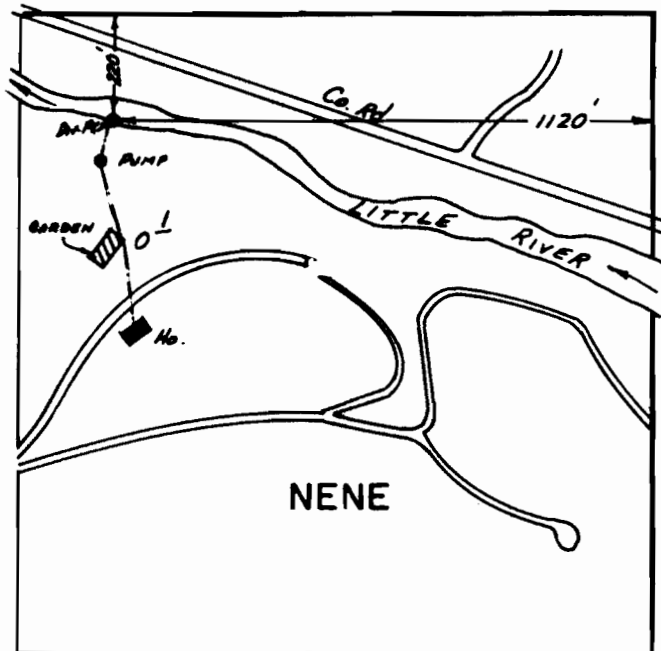

SCALE: 1" = 400'

FINAL PROOF SURVEY
UNDER

Application No. 49811 57501 Permit No. 37470 43357

IN NAME OF

Louis W. & Evelyn Y. Jackson

Surveyed JAN. 24. 19.80, by J.S. DONALDSON