


T. 38 S., R. 14 W., W. M.

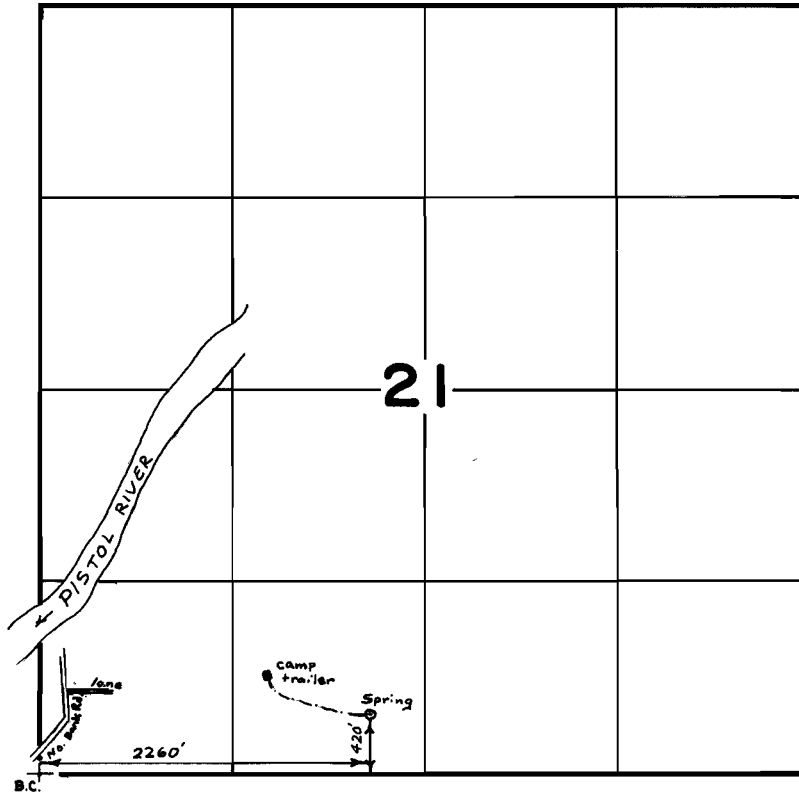

SCALE 4" = 1 mile

FINAL PROOF SURVEY
UNDER

Application No. 50302. Permit No. 37980.
IN NAME OF

.....FRANCIS SHRADER.....

Surveyed July 26, 1979, by S. Donaldson.