


T. 38S., R. 14W., W.M.

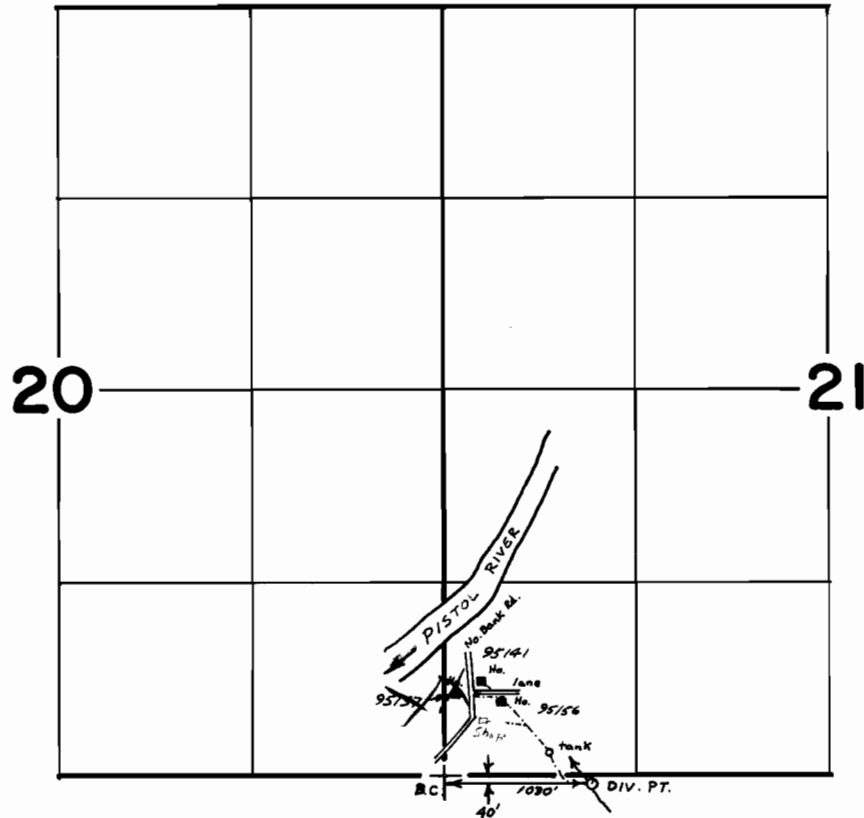

SCALE 4" = 1 mile

FINAL PROOF SURVEY UNDER

House Address = 95156

Application No. 50468.. Permit No. 38116.....
IN NAME OF

.....VEVA C. STANSELL.....

Surveyed July 26, 1979, by S. Donaldson...
July 26, 1988, by B.S. James