


P-38705
C-59057

T.14 S., R.30 E., W.M.

N

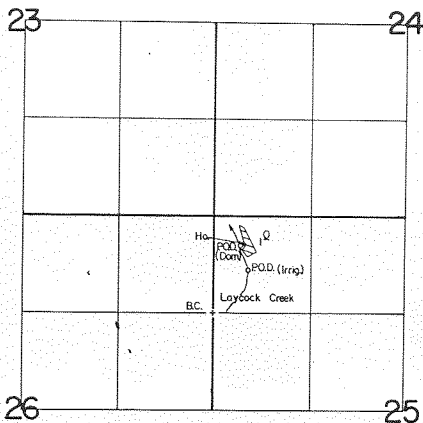

Dom. P.O.D. Loc.: 900' N. & 350' E.

Irrig. P.O.D. Loc.: 590' N. & 470' E., both from SW Cor.
NW 1/4 NW 1/4, Section 25.

Scale: 1" = 1320'

FINAL PROOF SURVEY
UNDER

Application No. 51240 Permit No. 38705
IN NAME OF

JOSEPH E. SCHMITZ & MARY J. VIK

Surveyed JUNE 17, 1988, by T. Warren

PTS. J.E.S.
11/24/88 TAW