


T. 9 S., R. 10 W., W.M.

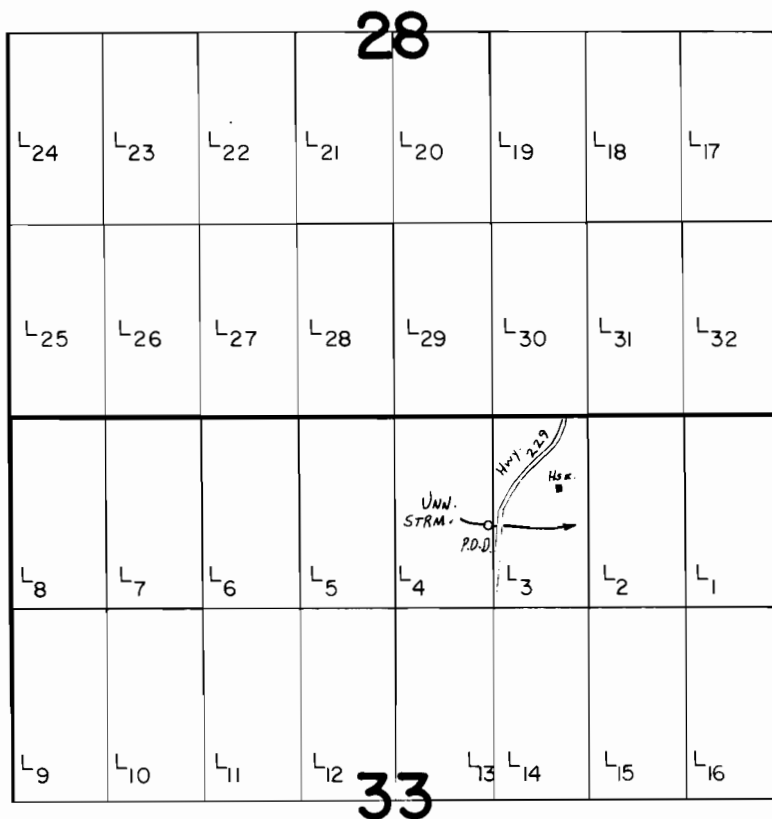

P.O.D. Loc.: 750' S. & 640' E. from N 1/4 Cor., Sec. 33.

Scale: 1" = 1320'

FINAL PROOF SURVEY

UNDER

Application No. 51298 Permit No. 38735
IN NAME OF

F. WILLIAM BURLEY

Surveyed Nov. 3 1987, by T. Warren