


T.14S., R.2W., W.M.

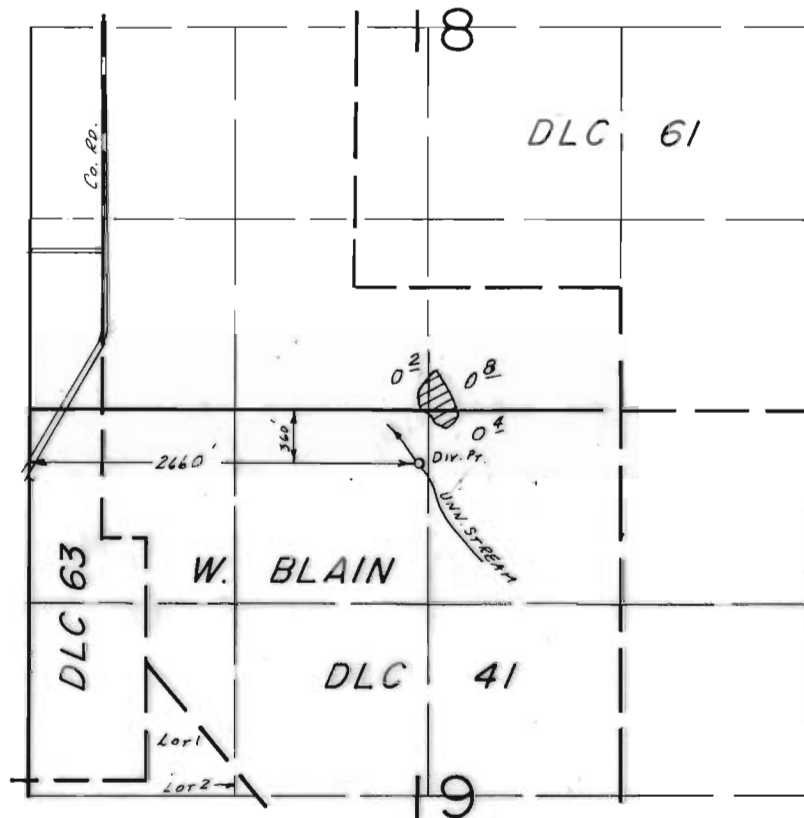

SCALE: 1" = 1320'

FINAL PROOF SURVEY UNDER

Application No. 52747.. Permit No. 39836.....
IN NAME OF

DANIEL L. DAVIS

Surveyed May 20.. 1986, by B.W. BISHOP.....

11/6/86
RUB

41043-278-62B