


T. 2S., R. 44E., W. M.

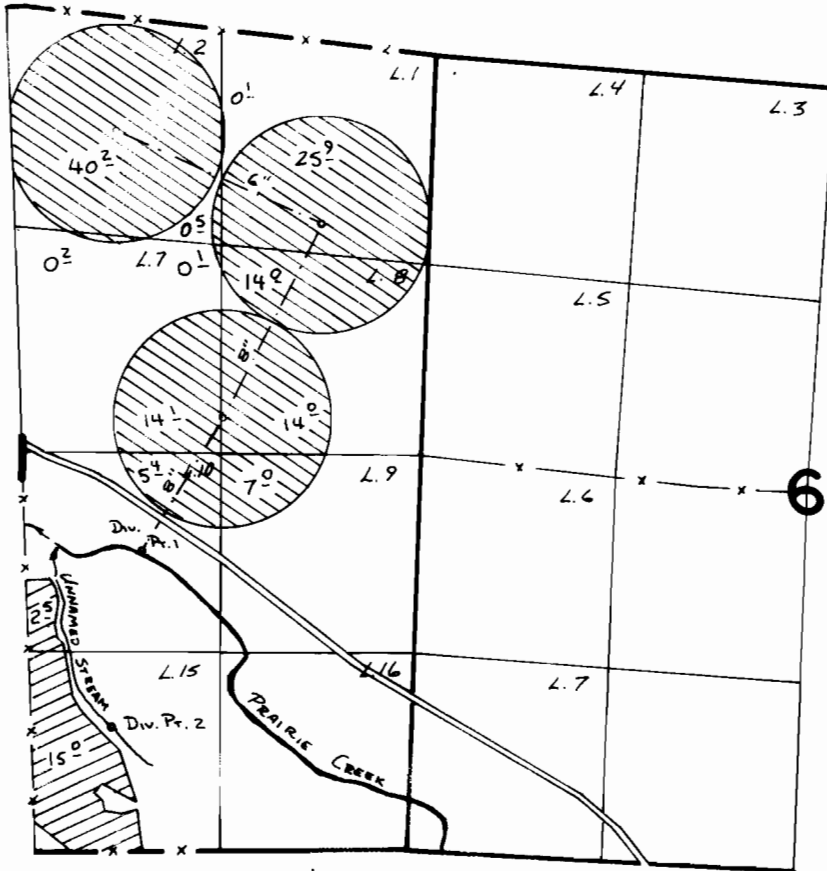

Div. Pt. 1 Loc: 2060'N. & 1890'W. FROM SE COR. SEC. 1  
 Div. Pt. 2 Loc: 850'N. & 2050'W. FROM SE COR. SEC. 2



Div. Pt. 1



Div. Pt. 2

**FINAL PROOF SURVEY**  
 UNDER

SCALE: 1" = 1320'

Application No. **54740**. Permit No. **41063**....  
 IN NAME OF

.....**DORIA L. AUDET**.....

Surveyed ..8..6..... 1984., by V.L. Church.....