


T. 14S. R. 1W. W. M.

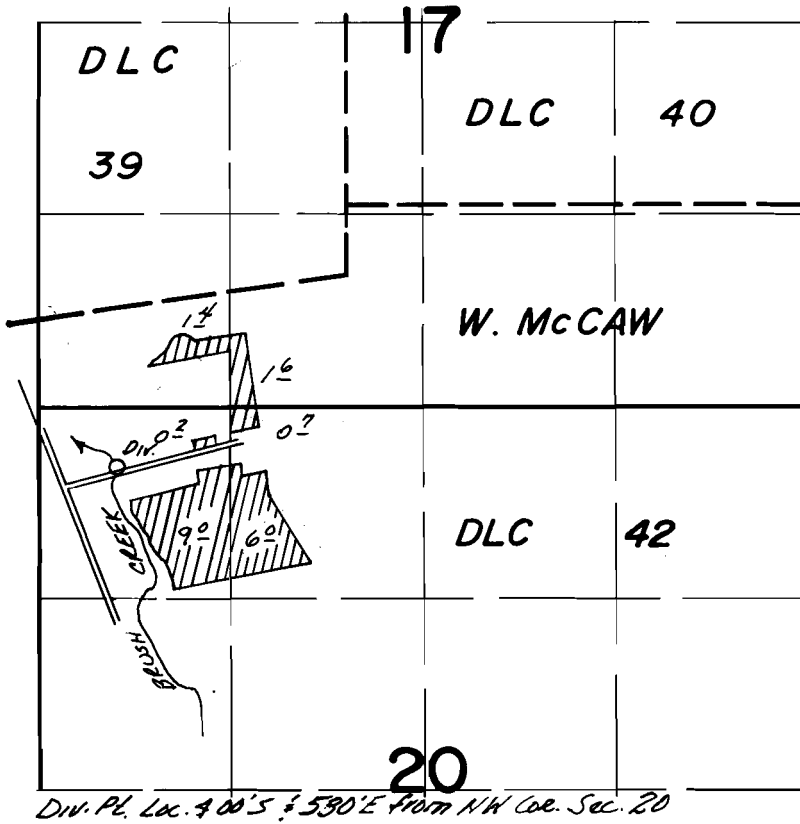

FINAL PROOF SURVEY UNDER

Application No. 55210.. Permit No. 41410.....
IN NAME OF

.....ALLEN & JOYCE MAY.....

Surveyed July...31.. 1979, by S.C. BROWN.....