


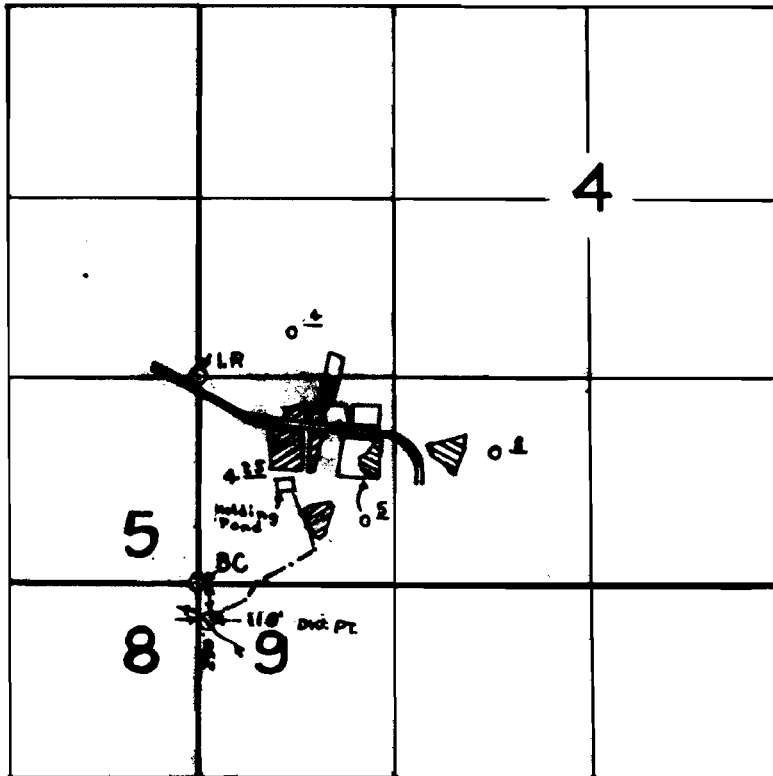

T. 29 S. R. 14 W. W.M.



FINAL PROOF SURVEY
 UNDER

-  Permits 41467, 47504
-  Permit 47504

Application No. 55207 41467
 .64733... Permit No. 47504.....
 IN NAME OF

RONNY O. HAGA

Surveyed Sept. 7, 1983., by S. Donaldson...