




T. 29 S. R. 14 W. W.M.

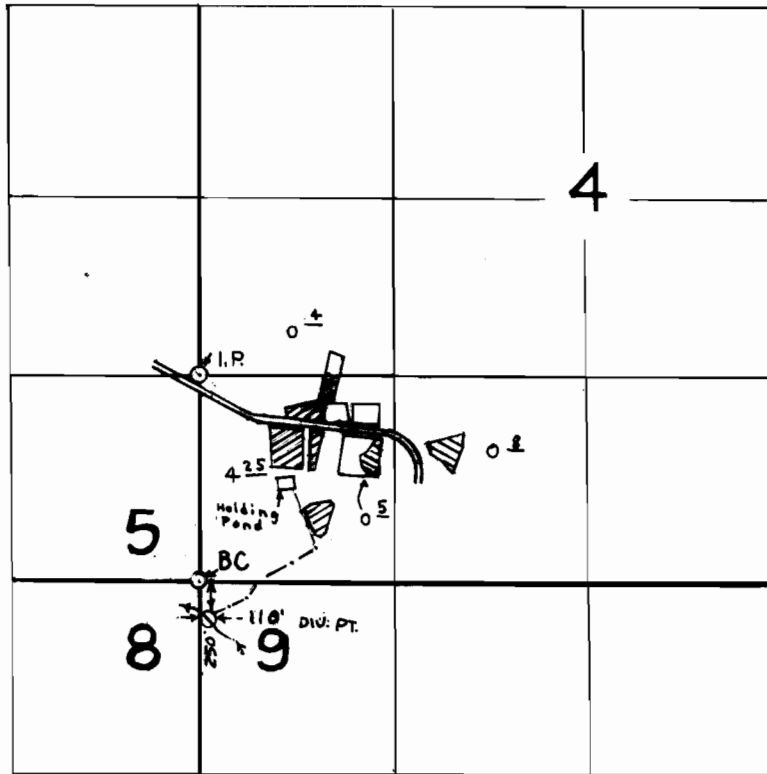

**FINAL PROOF SURVEY**  
UNDER

-  Permits 41467, 47504
-  Permit 47504

Application No. ~~55207~~ 64733... Permit No. ~~41467~~ 47504.....  
IN NAME OF

.....**RONNY O. HAGA**.....

Surveyed Sept. 7, 1983., by S. Donaldson.....