



T. 33 S., R. 2 E., W. M.

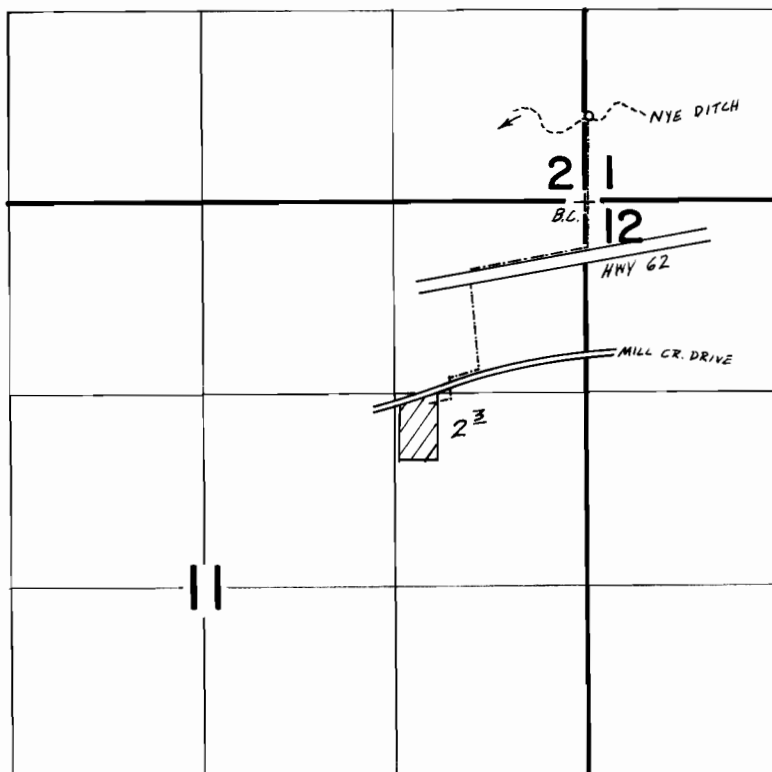

SCALE 1" = 1320'

T. 32 S., R. 3 E.

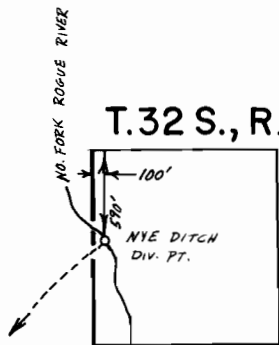

**FINAL PROOF SURVEY**  
UNDER

**SEC. 29**  
**NW 1/4 SW 1/4**

Application No. 55395 Permit No. 41537  
IN NAME OF

D. AILEEN &/or ARTHUR E. GARDNER

Surveyed May 24, 1983, by B.S. JAMES