


T. 37S., R.8W., W.M.

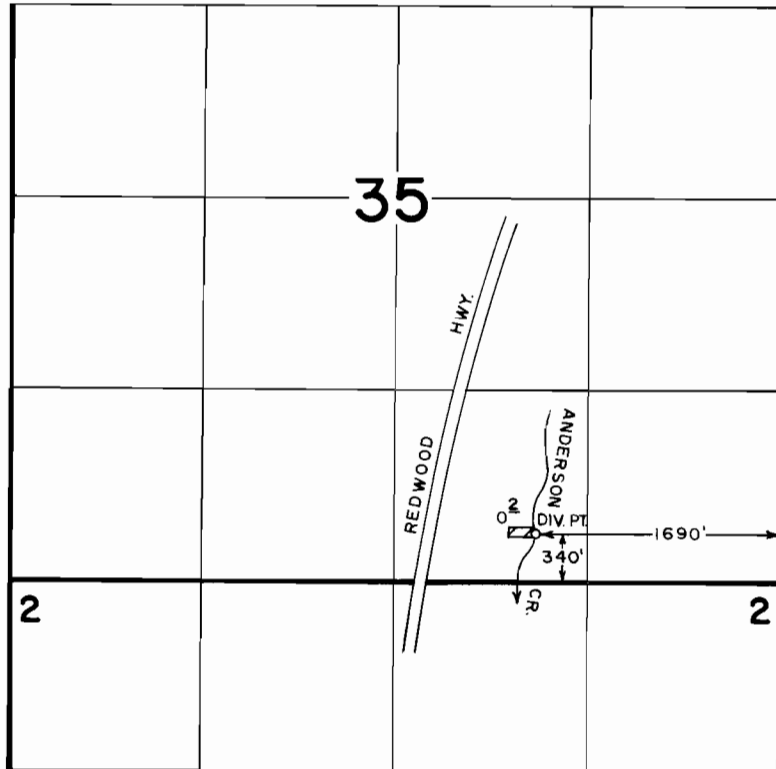

FINAL PROOF SURVEY
UNDER

Application No. 55465 Permit No. 41829
IN NAME OF

MR. & MRS. ANTONIO HOLGUIN

Surveyed OCT. 26, 1983, by B.S. JAMES

SCALE: 4" = 1 MILE