


T. 34S., R. 8W., W.M.

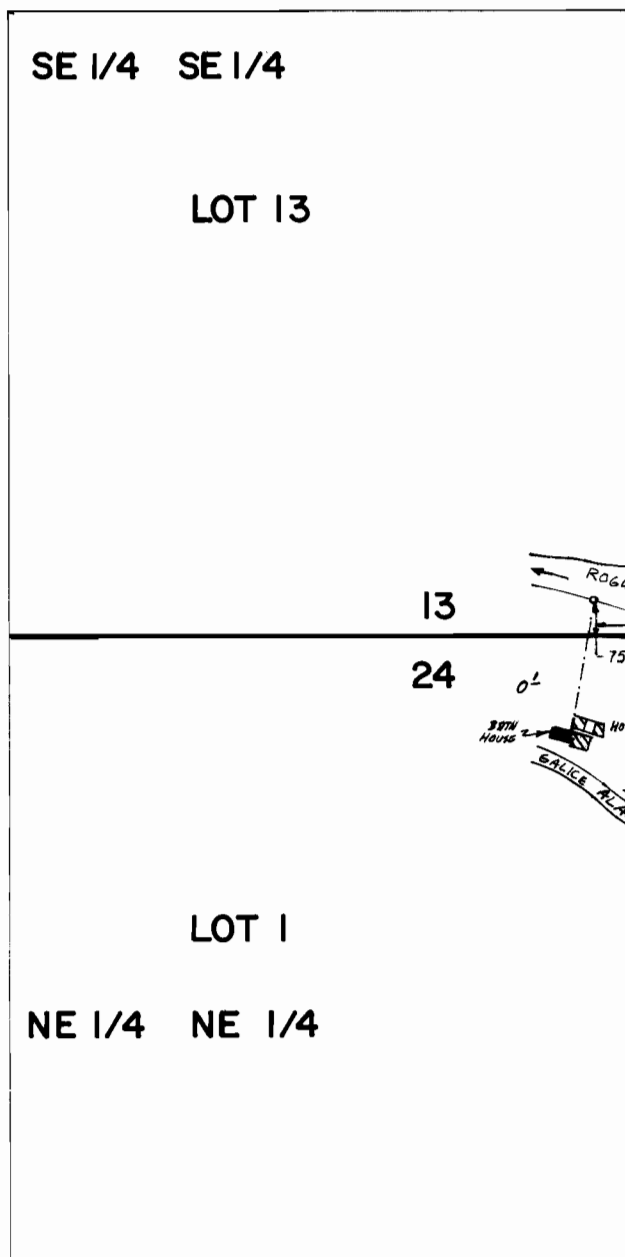

SCALE : 1" = 400'

**FINAL PROOF SURVEY**  
UNDER

Application No. **55099** Permit No. **41866**

IN NAME OF

**SUNDANCE EXPEDITIONS, INC.**

Surveyed **JUNE 27 1984**, by **B. S. JAMES**