
T. IIS. R.4W. W.M.

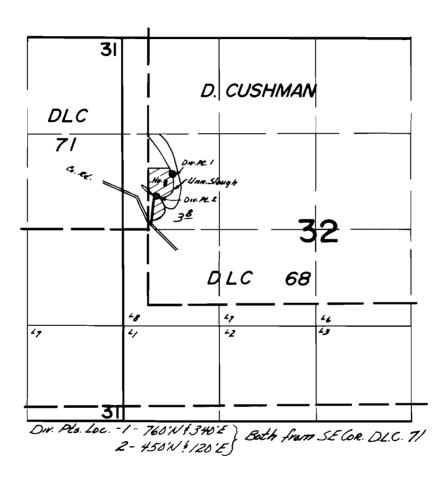

FINAL PROOF SURVEY

UNDER

Application No. 563Q8 Permit No. 4.2Q15 IN NAME OF
NORRIS W. CARLSON
Surveyed April25. 1979., by S.C.BROWN