
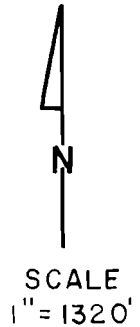


T. 3 S. R. 4 W. WM

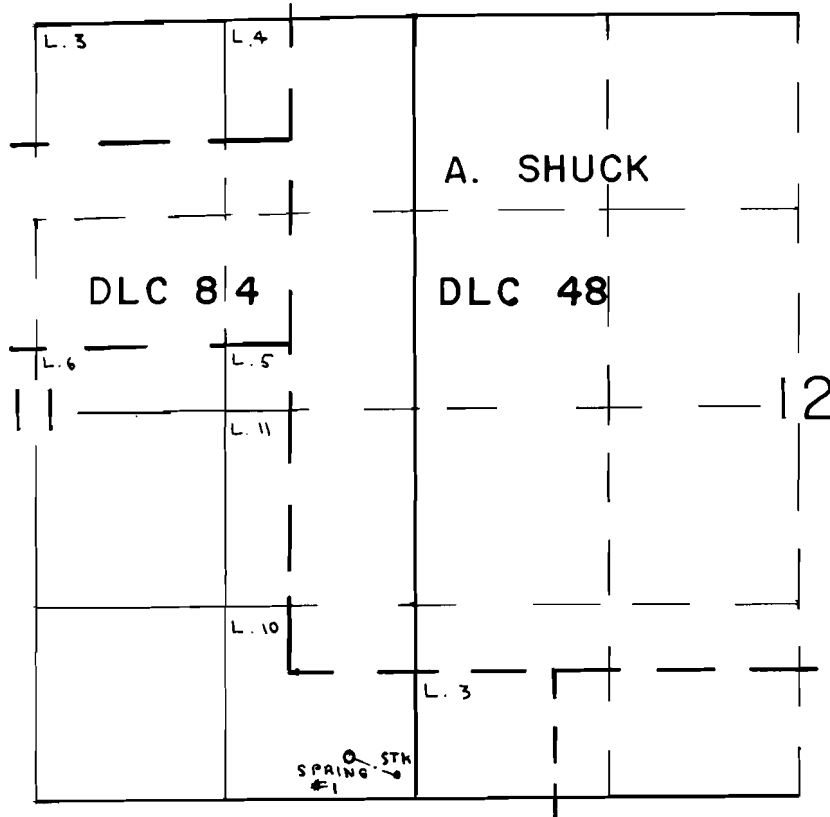

DIV. PT. LOC.: 580' S & 410' E OF SW COR. DLC 48

FINAL PROOF SURVEY UNDER

Application No. 56416 Permit No. 42498
IN NAME OF

ERVIN E. BRISCO

Surveyed JUL 5 1984, by P. PAGTER