


T.13S.,R.1W.,W.M.

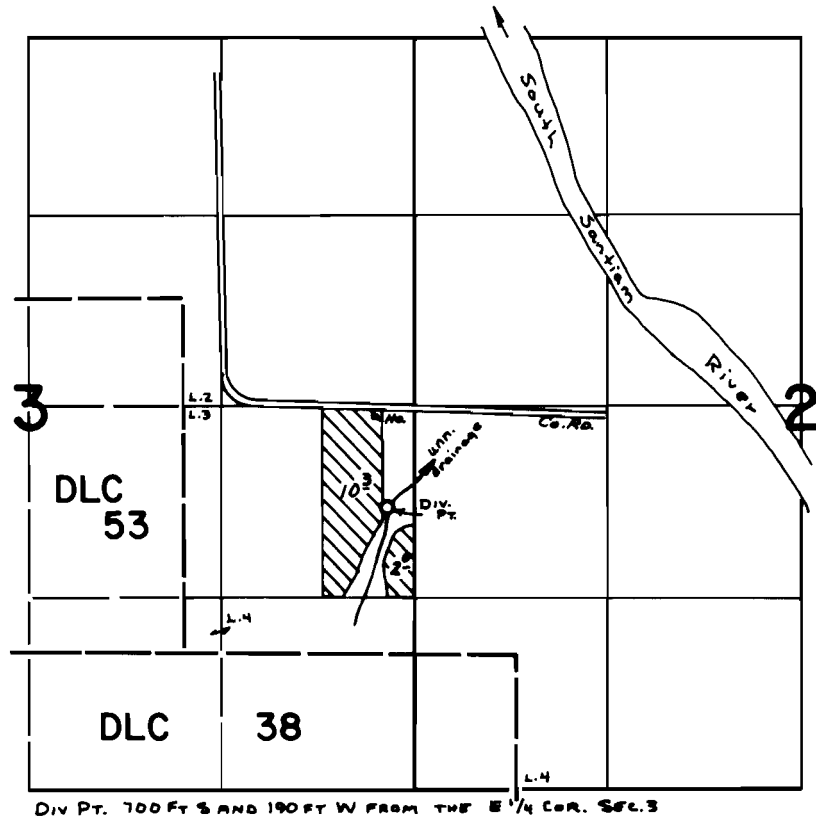

FINAL PROOF SURVEY UNDER

Application No. ...56618.. Permit No. ...42517.....
IN NAME OF

RICHARD...L...&...MARTHA...B...PORTER

Surveyed .April..23. 19.82., by ..L..M..IOLL.....