


T. 1N., R. 10E., W.M.

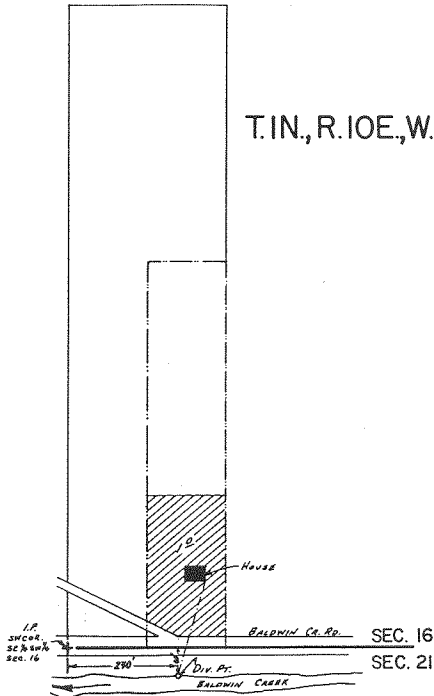

SCALE: 1" = 200'

FINAL PROOF SURVEY
UNDER

Application No. 56085. Permit No. 42529.....
IN NAME OF

.....KENNEDY & LUCIA HAWKINS.....

Surveyed APR. 17... 1980, by R.G. MUCKEN.....

APPLICATION MAP &
CHAIN SURVEY *But*