


T. 40 S., R. 8 W., W. M.

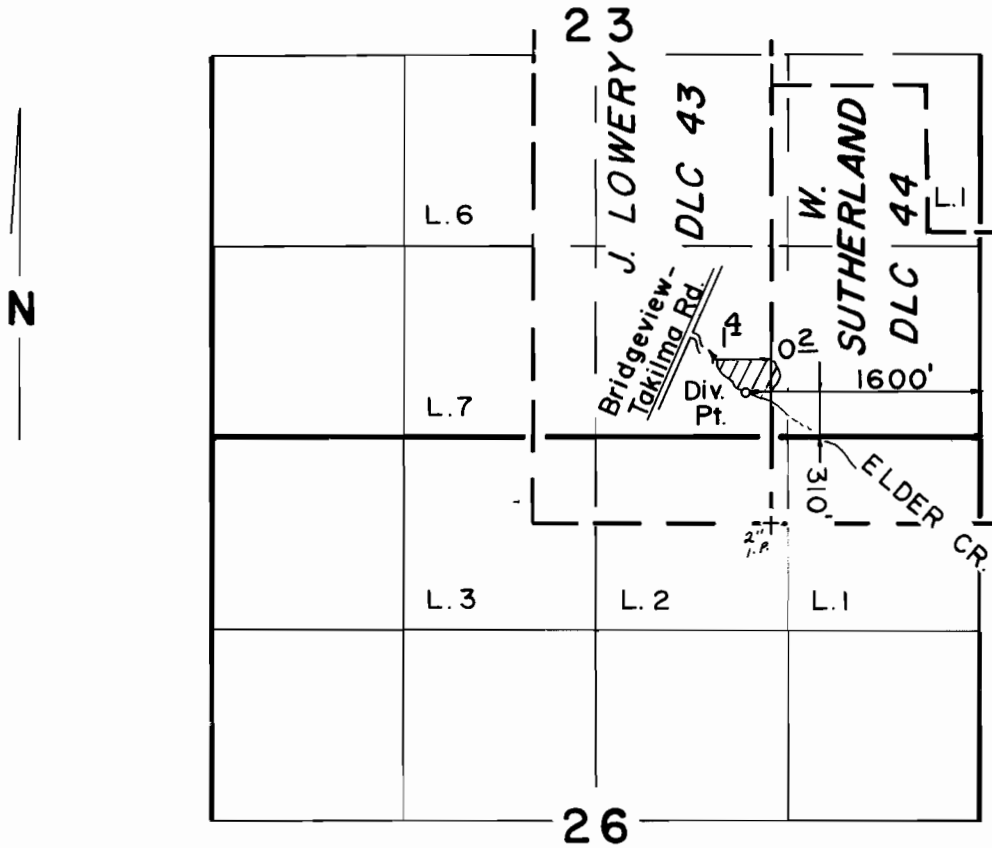

Scale: 1" = 1320'

FINAL PROOF SURVEY
UNDER

Application No. **55455** Permit No. **42552**
IN NAME OF

WAYNE C. FILLOON

Surveyed APR. 2, 1986, by B. S. JAMES.