


T. 38 S., R. 7 W., W.M.

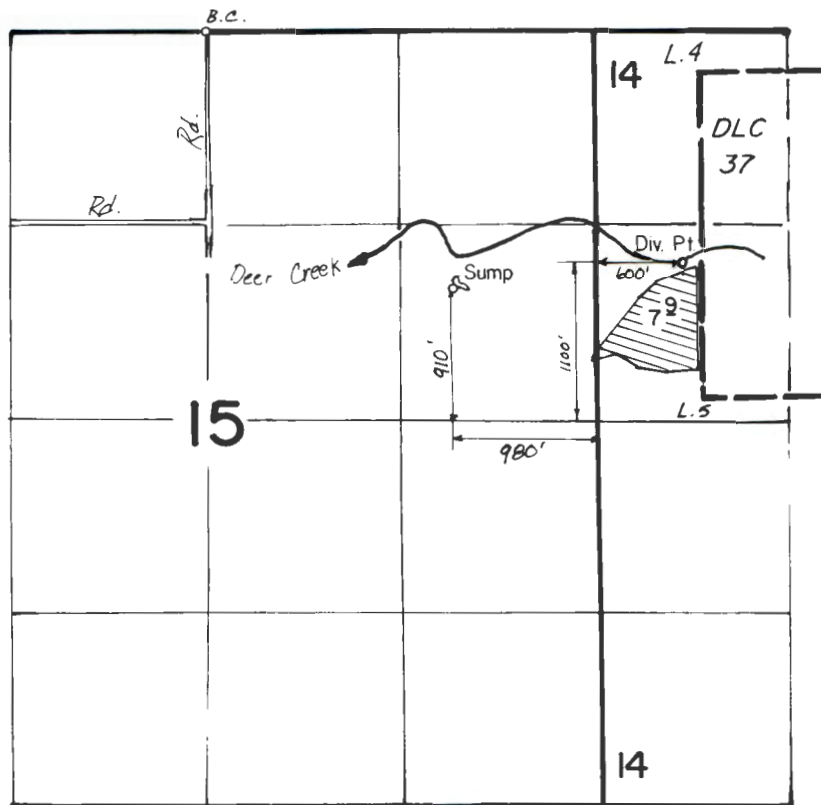

FINAL PROOF SURVEY
UNDER

TRANSFER NO. 3784

Application No. 56765 Permit No. 42588

IN NAME OF

HOWARD BARBER

Surveyed OCT. 27, 1983, by B.S. JAMES