


T. 12S., R. 1E., W.M.

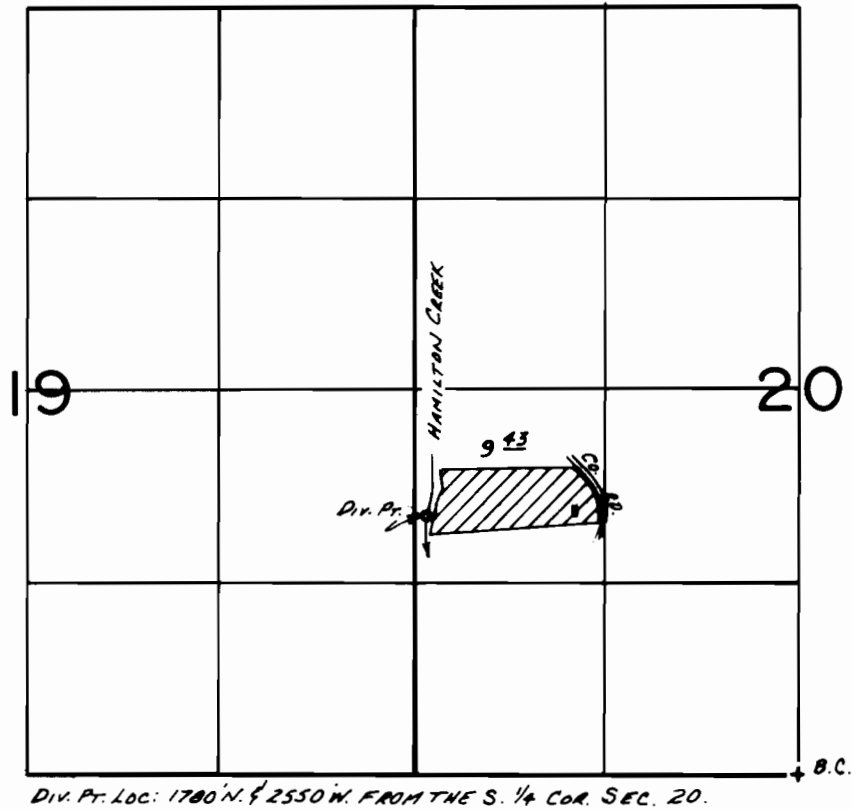

FINAL PROOF SURVEY
UNDER

Application No. 56782.. Permit No. 42615.....
IN NAME OF

EARL W. & JUDITH A. PRESLEY.

Surveyed APR. 30. 1982, by L.M. TOLL.....