


# T. 2 N., R. 9 W., W.M.

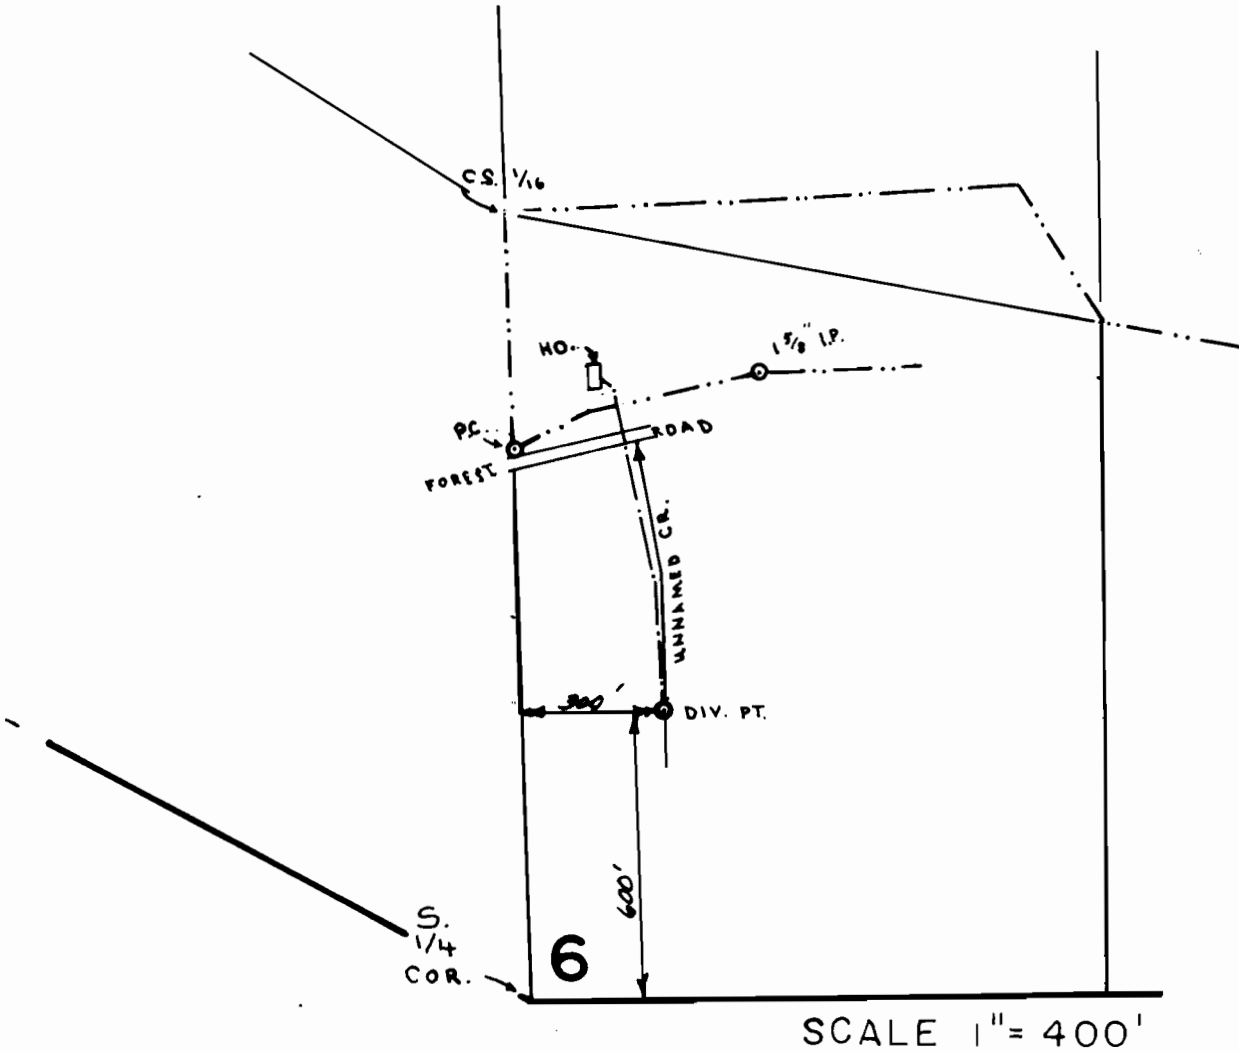

## FINAL PROOF SURVEY UNDER

Application No. 56756 Permit No. 42619.....

IN NAME OF

HOMER H. & BETTY L. WAINRIGHT

Surveyed OCT. 25, 1983, by PAGTER.....