


T.16S.,R.2E.,W.M.

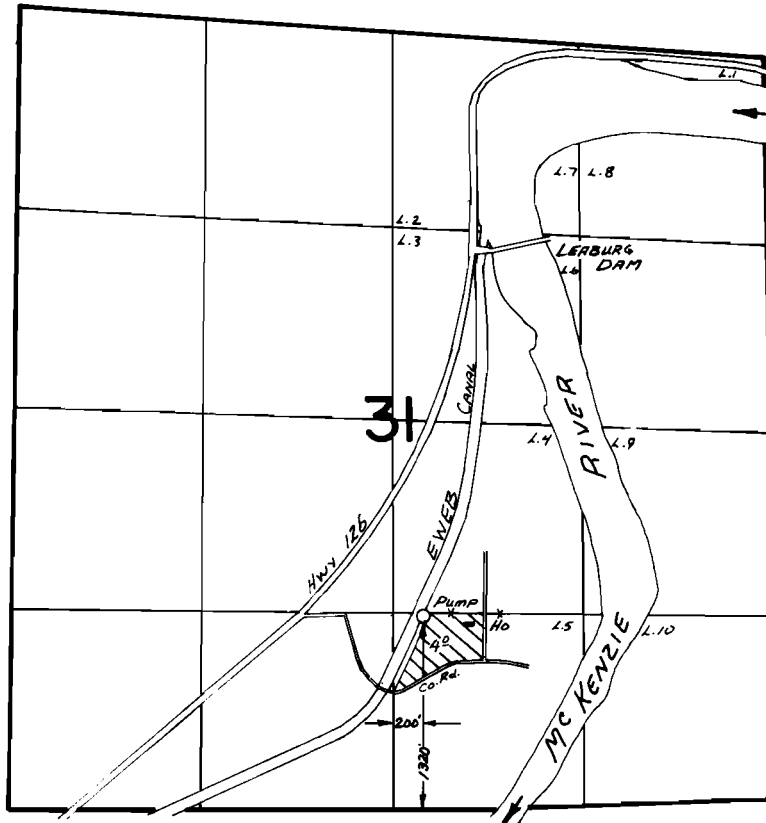

**FINAL PROOF SURVEY**  
UNDER

Application No. 56495.. Permit No. 42630.....  
IN NAME OF

.....**W. H. & NELLIE M. POFF**.....

Surveyed Aug. 21. 1981., by S.C. BROWN.....