


T.8S., R.46E., W.M.

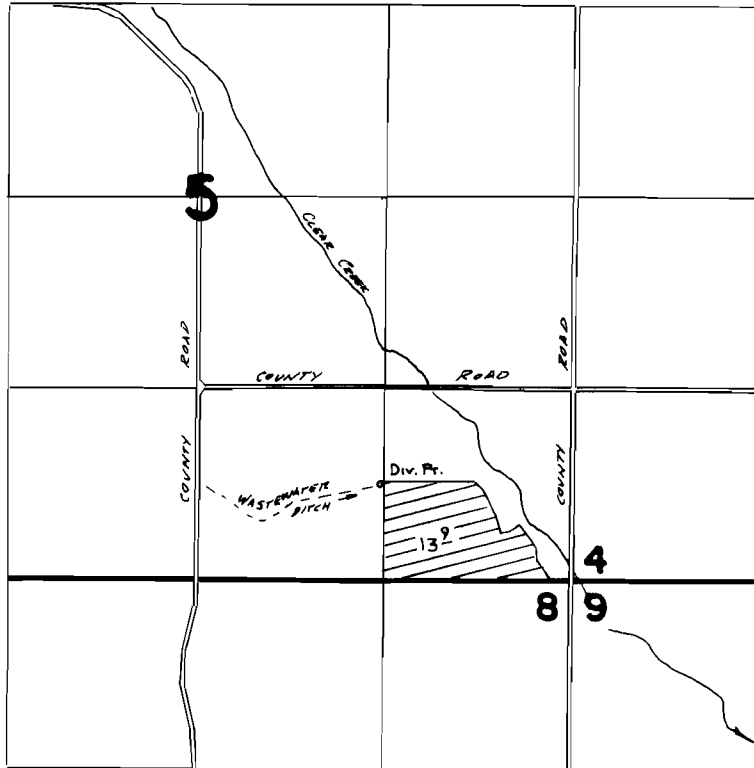

Div. Pt. Loc: 660'N & 1320'W FROM SE COR. SEC 5

**FINAL PROOF SURVEY**  
UNDER

Application No. **56515**... Permit No. **42655**.....  
IN NAME OF

.....**ROBERTA A. CORDOZA**.....

Surveyed *July 19*..... 19*82*., by *V.L. Church*.....