


T. 33 S., R. 7 W., W. M.

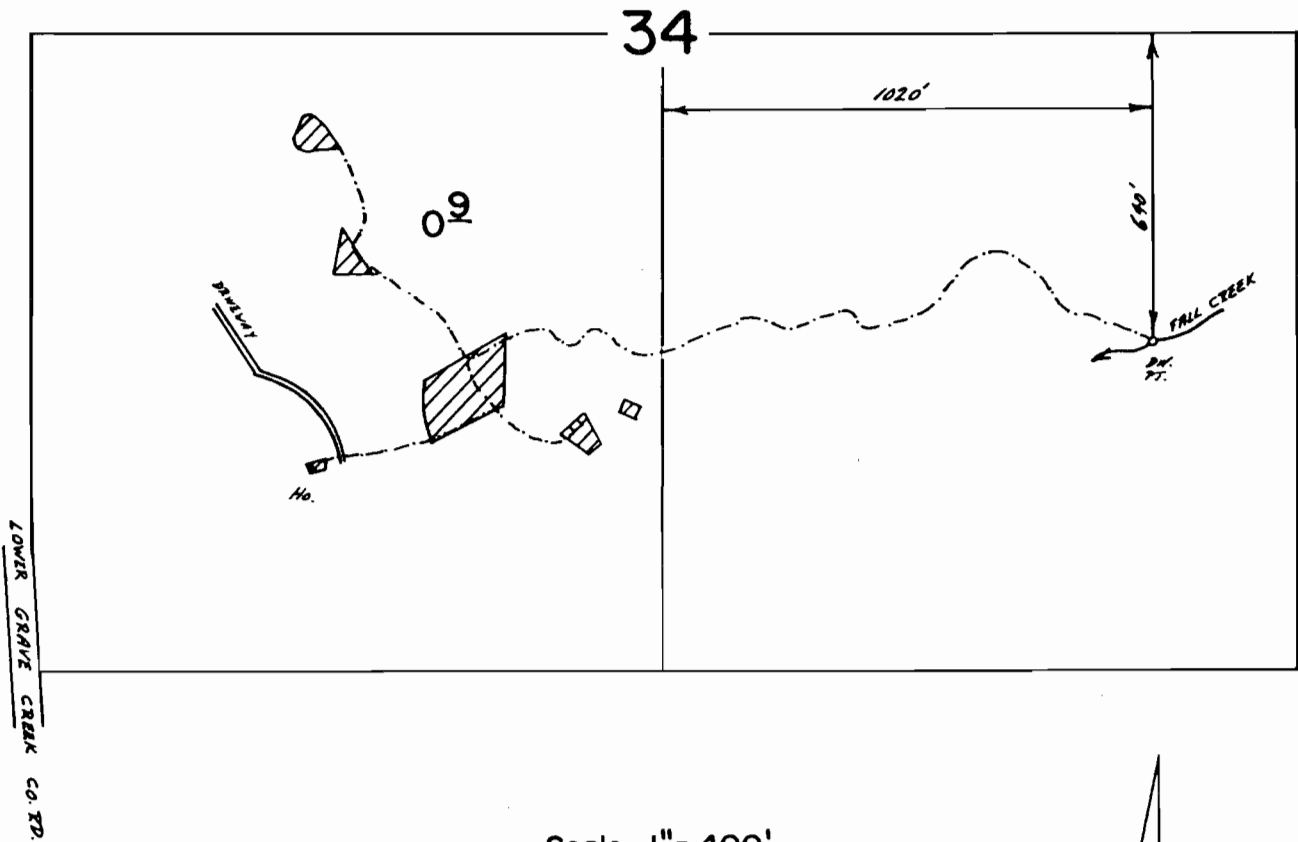

Scale 1" = 400'



FINAL PROOF SURVEY
UNDER

Application No. 57323 Permit No. 43538
IN NAME OF

BOB JIRUCHA

Surveyed Sept. 27, 1984, by J.R. WOODROOF