


T. 11 S., R. 8 W., W. M.

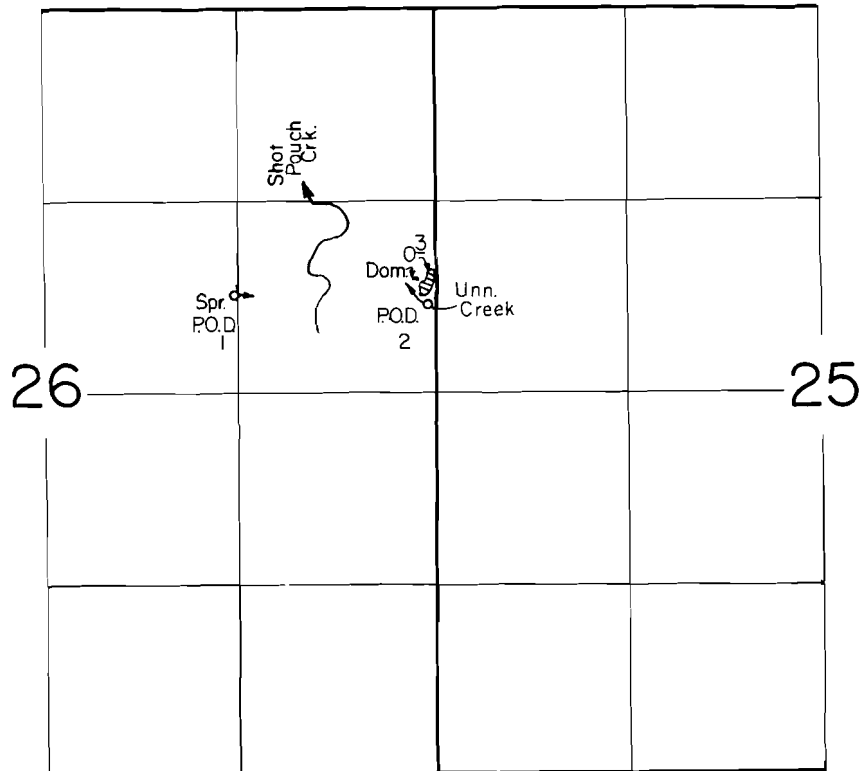

P.O.D. 1 Loc.: 1950' S. & 30' W.

P.O.D. 2 Loc.: 2030' S. & 1300' E., both from NW Cor.,
NE 1/4 NE 1/4, Sec. 26.

Scale: 1" = 1320'

FINAL PROOF SURVEY UNDER

Application No. 58412... Permit No. 44196....

IN NAME OF

ROBERT L. & ELSIE L. RUSSELL

Surveyed May 25, 1988., by T. Warren.....

41041-372-140

10/12/88

T.M.W.