


T. 30 S., R. 6 W., W.M.
SECTION 15

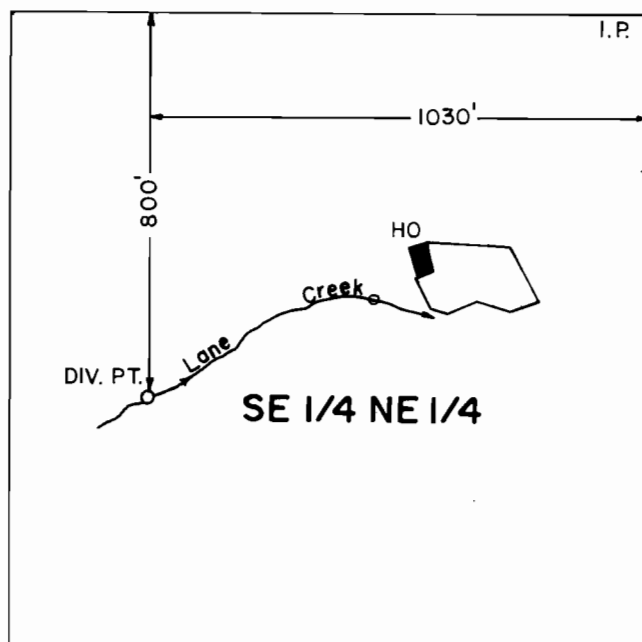

SCALE 1" = 400'

FINAL PROOF SURVEY
UNDER

Application No. 58565... Permit No. 44247.....
IN NAME OF

DAVID E. HAUSOTTER

Surveyed JUNE 28 1984, by L. E. CASHION.